

NW 1 28 23

FROM THE OFFICE OF

CHARLES O. GEORGI COMPANY

2215 West County Road B

Saint Paul, Minnesota 55113

REGISTERED CIVIL ENGINEER AND LAND SURVEYOR

Certificate of Survey

I Hereby Certify that this plat shows a survey made by me of the property described on this plat, and that the corners are correctly placed as shown, and that all locations have been correctly shown.

C.D. District #8

Parcel No 140-B

Area: 3456 Sq. Ft., M.O.L.

Description:

The East 20.0 feet of Lot 4, Block 6,
Woodland Park Addition to the City of St. Paul,
Ramsey County, Minnesota


Surveyed For *Housing Authority*

Date *Nov. 1977*

Scale *1" = 40'*

By

Charles O. Georgi
REGISTERED LAND SURVEYOR

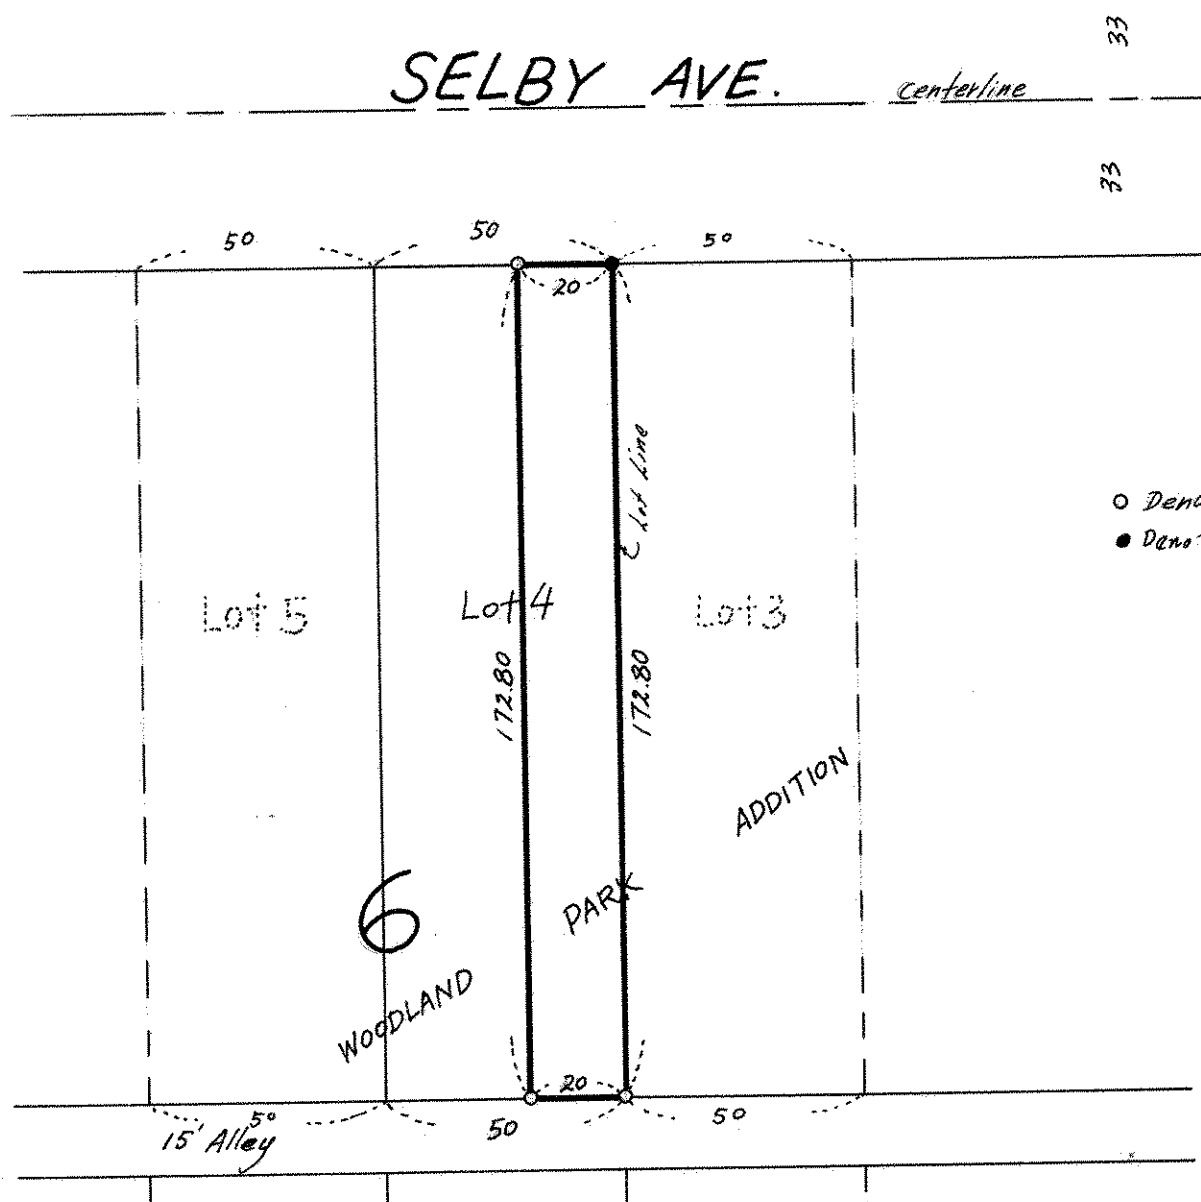

○ Denotes Iron Monument
● Denotes Iron Found in place