

FROM THE OFFICE OF

CHARLES O. GEORGI COMPANY

2215 West County Road B

Saint Paul, Minnesota 55113

REGISTERED CIVIL ENGINEER AND LAND SURVEYOR

**Certificate
of Survey**

C.D. District No. 8

Parcel 123-B

Area 43,568 sq. ft. m.o.l.

I Heroby Certify that this plat shows a survey made by me of the property described on this plat, and that the corners are correctly placed as shown, and that all locations have been correctly shown.

Surveyed For Housing Authority

Date Sept 1977


Scale 1" = 100'

By

Charles O. Georgi
REGISTERED LAND SURVEYOR

Description:

Lot 16, 17, 18, 19, 20, 21, 22, 23, 24 and 25,
Block 3, Holcombe's Addition,
Ramsey County, Minnesota.

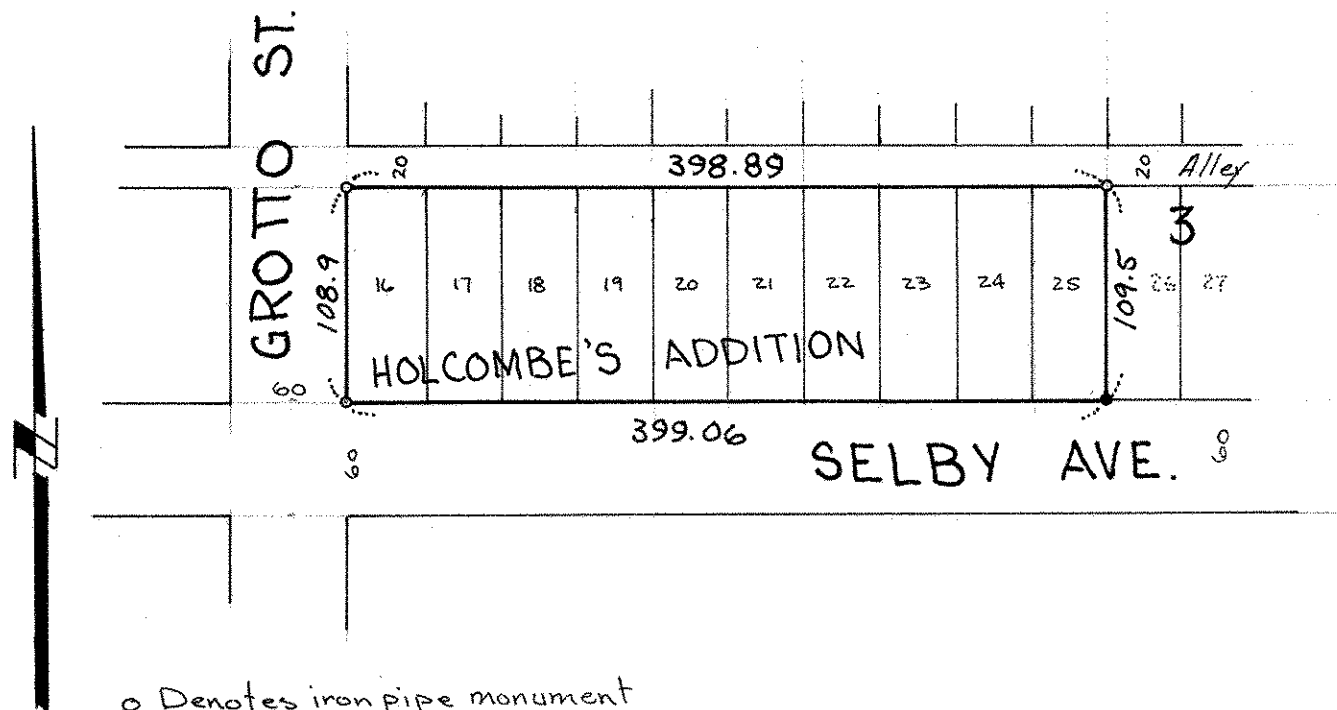

o Denotes iron pipe monument

• Denotes iron pipe monument found in place