

FROM THE OFFICE OF

CHARLES O. GEORGI COMPANY

2215 West County Road B

Saint Paul, Minnesota 55113

REGISTERED CIVIL ENGINEER AND LAND SURVEYOR

**Certificate
of Survey**

CD District No 8
Parcel No. 108-A
Area 3,508 sq.ft. m.o.l.

I Heroby Certify that this plat shows a survey made by me of the property described on this plat, and that the corners are correctly placed as shown, and that all locations have been correctly shown.

Surveyed For Housing Authority

Date July 1977


Scale 1" = 40'

By *Charles O. Georgi*
REGISTERED LAND SURVEYOR

Description:

The Westerly 4.0 feet of the Northerly 80.0 feet
of lot 2 and the Northerly 80.0 feet of
lot 3, Block 2, Holcombe's Addition,
Ramsey County, Minnesota.

North line of Section 2, T28R23
MARSHALL AVE.

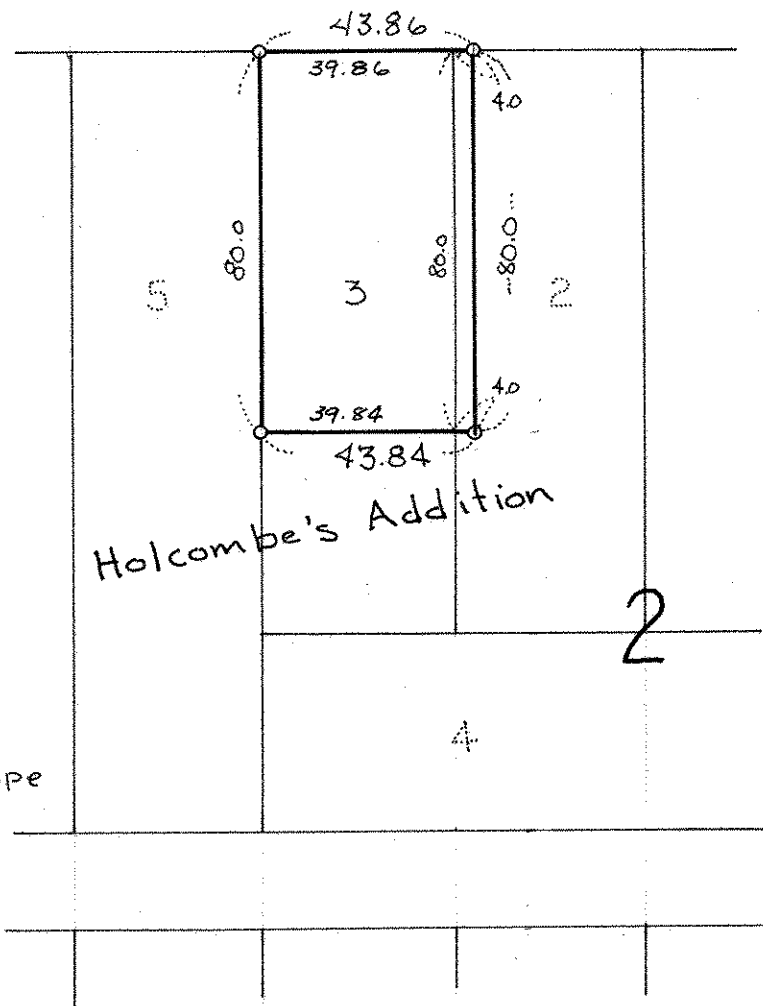

o Denotes iron pipe
monument.