

FROM THE OFFICE OF

CHARLES O. GEORGI COMPANY

2215 West County Road B

Saint Paul 13, Minnesota

REGISTERED CIVIL ENGINEER AND LAND SURVEYOR

Certificate of Survey

I Hereby Certify that this plat shows a survey made by me of the property described on this plat, and that the corners are correctly placed as shown, and that all locations have been correctly shown.

Surveyed For Mr. EARL Dudley

Date..... May 1961.....

Scale..... 1" = 40'


By Charles O. Longi
REGISTERED LAND SURVEYOR

Description:

The Westerly 30 feet of Lot 6, Block 1
HALLER'S ADDITION to St. Paul

Note:

The above description
as furnished by owner
should include rights
and limitations for the
Common concrete driveway.

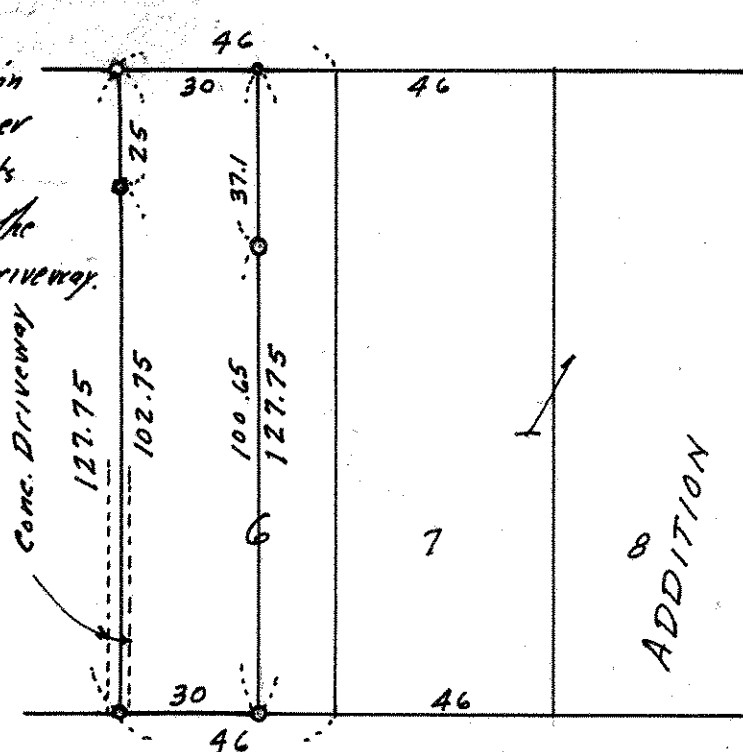

VICTORIA ST

DAYTON Ave.

• Denotes Iron Monument.

HALLER: