

1400
MARSHALL

AVE.

SITE MAP

JENNIFER C. BELL
ST. PAUL, MINN.

Dennis Carrin
Melwyn Bell
445-1086
800-643-5810 Arkansas

N

Survey of West 2ft. of Lot 1 and all of
Lots 2 thru 7 and East 1/2 of Lots 8 and
23, and all of Lots 24 thru 29 together
with vacated alley in B.K. 1, Boulevard
Add. to St. Paul, Ramsey Co. Minn.
~~and showing plant layout for~~
~~M. & C. Petroleum Corp. of~~
~~Tulsa, Okla.~~

Scale 1" = 20 ft. Aug. 10 1953
This Plat is a correct delineation
of this Survey

Edgar C. Swenson
Minn. Reg. C.E. & Surveyor
No. 567

Scale OK Sheet size - 22"x34"


Billing [PO Box 238,
Shakopee, Minn 55379

Chemex Property
defined by circles
(Require revised site plan,
critical elevations for
drainage, utilities, etc.)
Engineers to show proposed
improvements, section w/
elevations through diked
area, existing piping
diagram (schematic) pumps,
electrical river diagram

PLAN SHEET

Total 77,814 Sq. ft.
12,500 parking
64,314


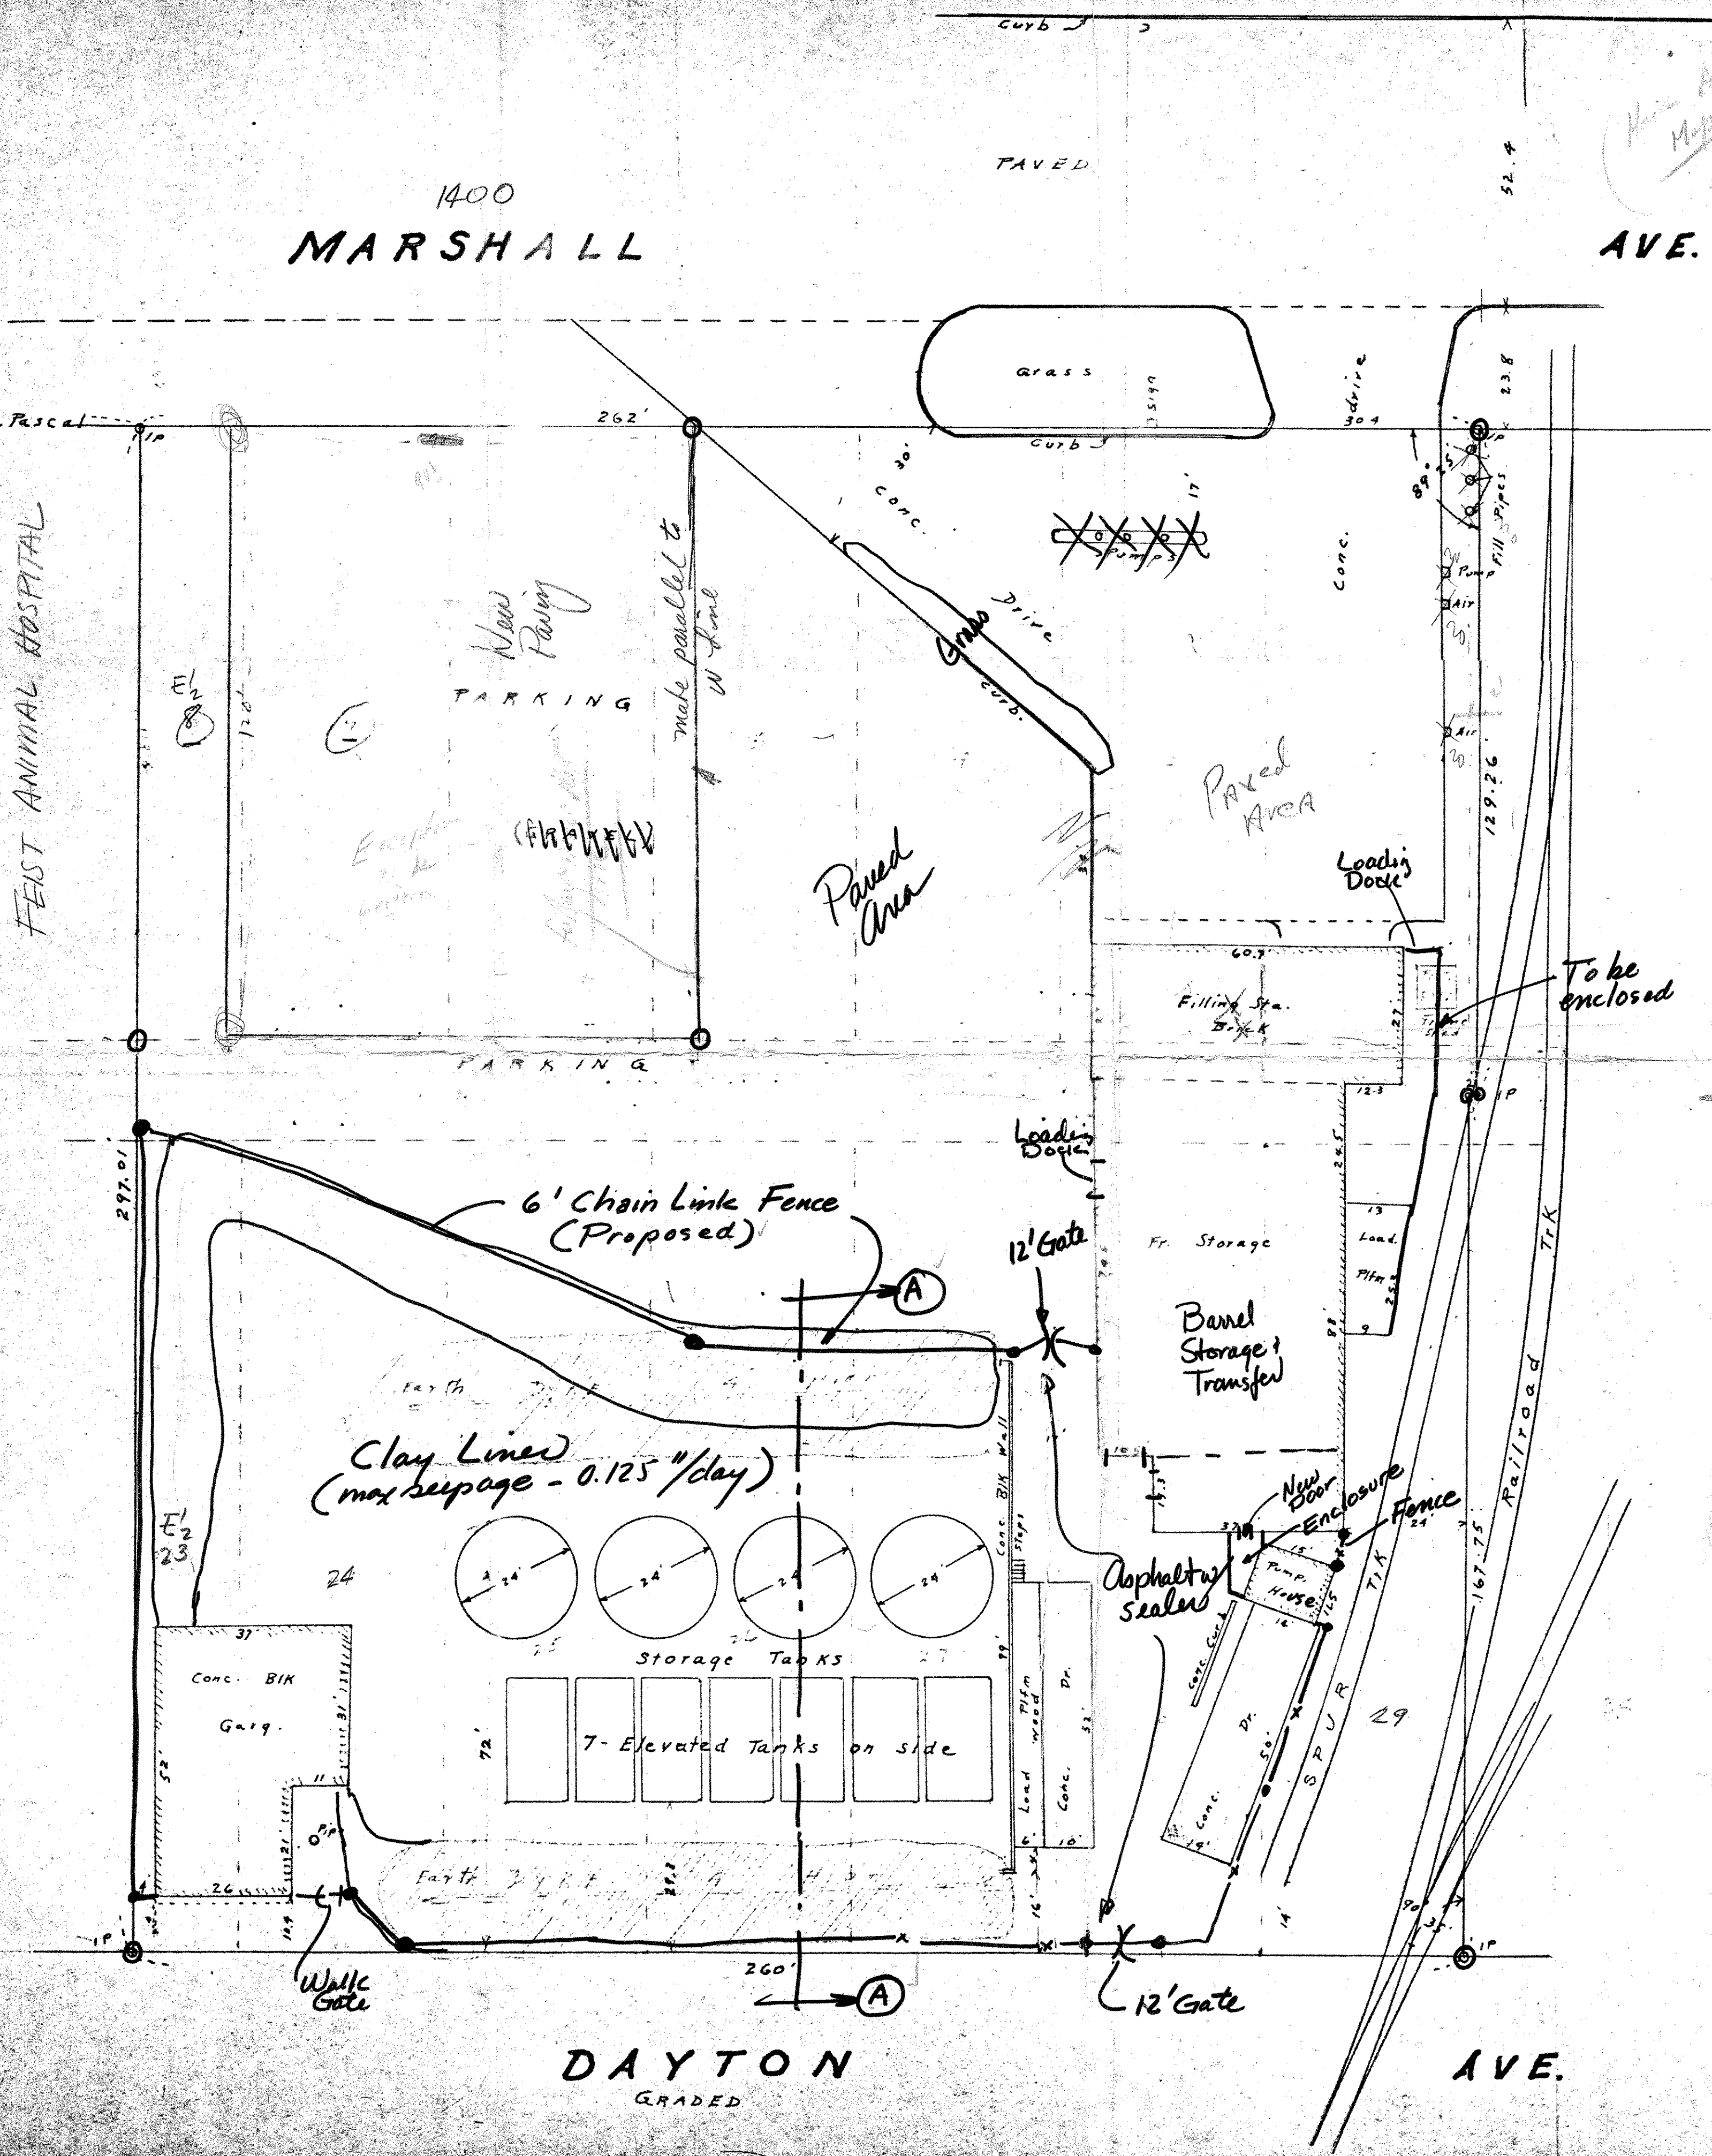

AVE.