

FROM THE OFFICE OF

2215 West County Road B

Saint Paul 13, Minnesota

REGISTERED CIVIL ENGINEER AND LAND SURVEYOR

Certificate of Survey

I Hereby Certify that this plat shows a survey made by me of the property described on this plat, and that the corners are correctly placed as shown, and that all locations have been correctly shown.

Surveyed For Vernon L. Zobel


Date..... April 1965

Scale..... 1" = 50'

By Charles C. Lepski
REGISTERED LAND SURVEYOR

Description:

Lot 2, Block 1, Lewiston Heights.
Ramsey County, Minnesota.

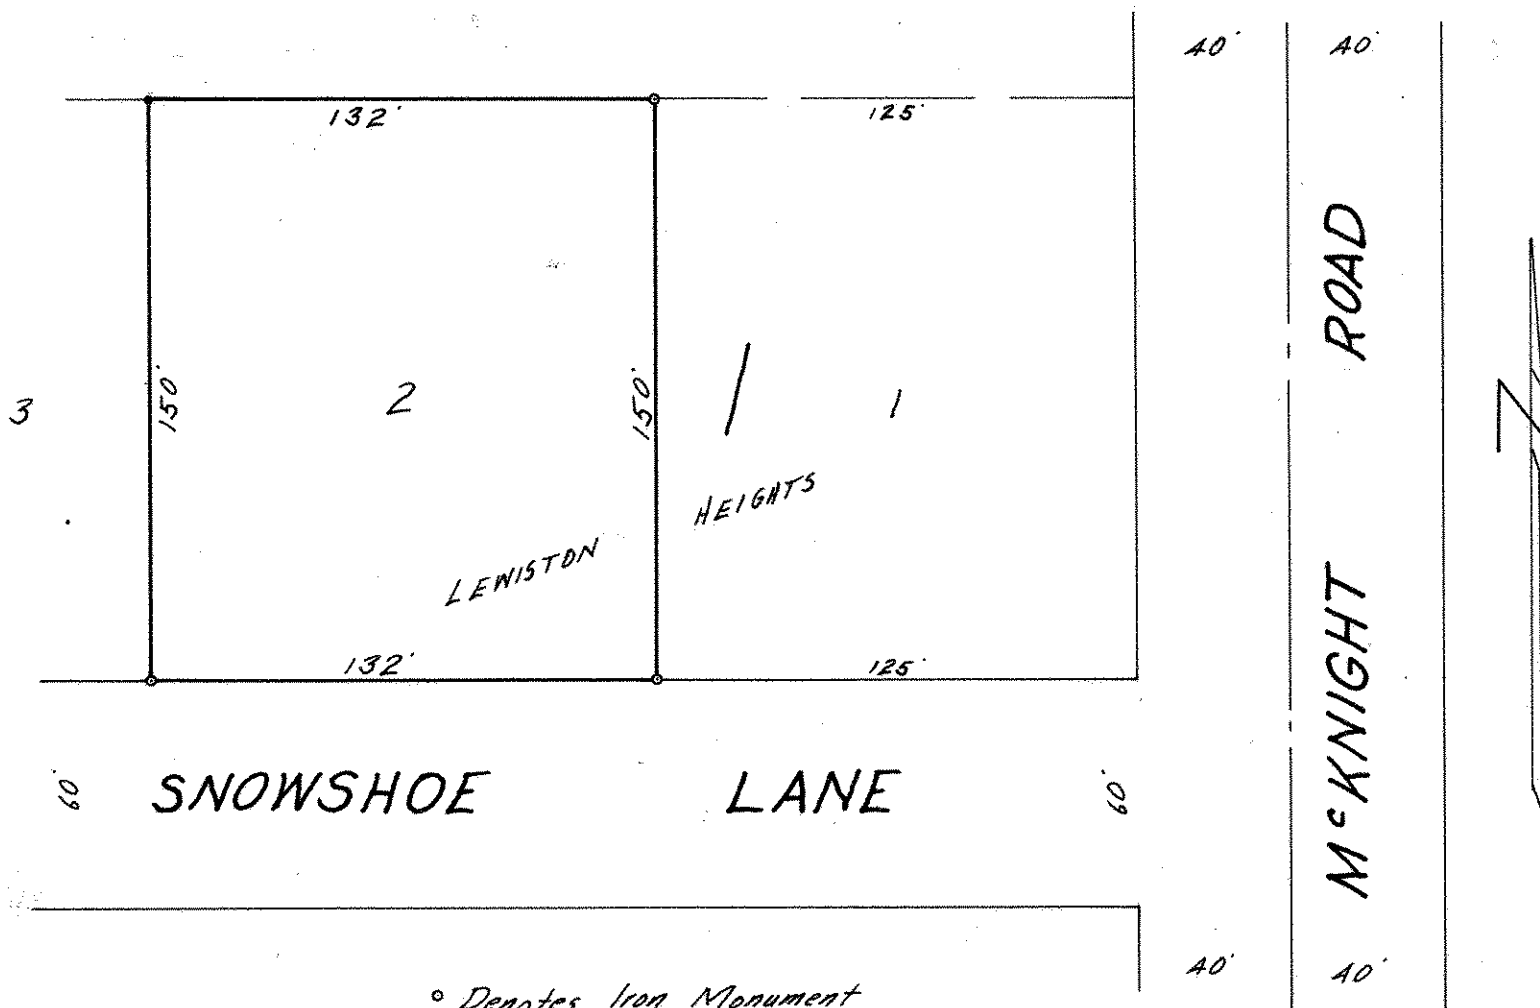

• Denotes Iron Monument

Fence post at N.W. corner of property,
set nail in fence post.