

FROM THE OFFICE OF

CHARLES O. GEORGI COMPANY

2215 West County Road B

Saint Paul, Minnesota 55113

REGISTERED CIVIL ENGINEER AND LAND SURVEYOR

**Certificate
of Survey**

I Hereby Certify that this plat shows a survey made by me of the property described on this plat, and that the corners are correctly placed as shown, and that all locations have been correctly shown.

Surveyed For *Mrs. Zerwas*

Date *September, 1971*

Scale *1" = 30'*

By


Charles O. Georgi
REGISTERED LAND SURVEYOR

Description:

*Lot 3, Block 2, Electric Addition,

Note:

*Placed front corners
by walk per owners
request.*

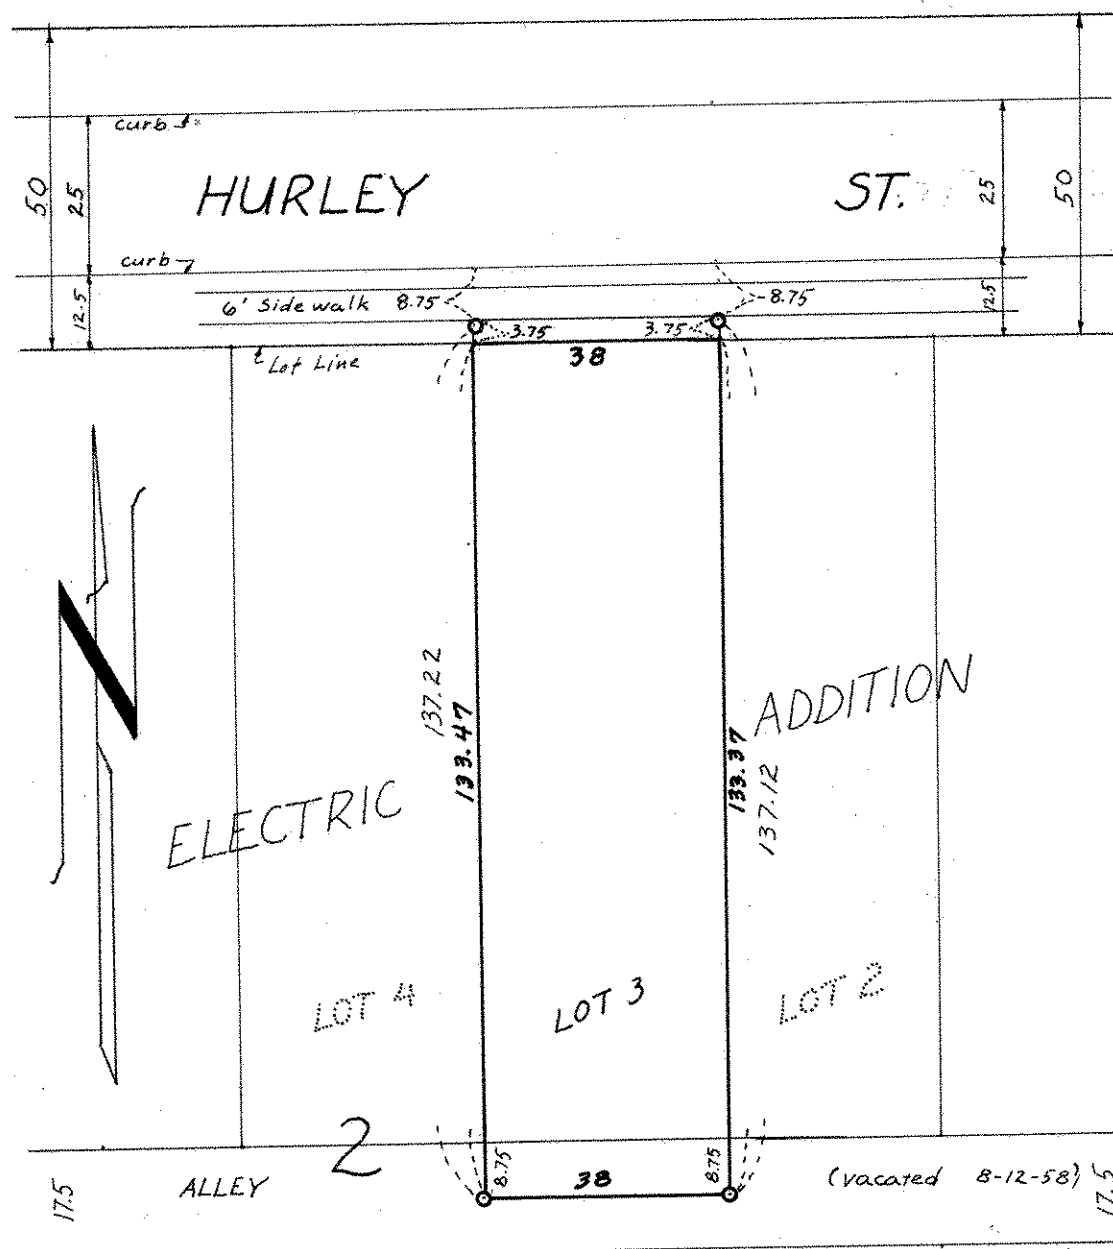

o Denotes Iron Pipe Monument