

Certificate of Survey

From the office of
GEORGI SCHMIDT & ASSOC. INC.
 3092 No. Lexington Ave., Roseville, Mn. 55113
 LAND SURVEYING
 483-4408

I Hereby Certify that this plat shows a survey made by me of the property described on this plat, ~~and that the corners are correctly placed as shown,~~ that this survey, plan or report was prepared by me, or under my direct supervision; and that I am a duly registered Land Surveyor under the Laws of the State of Minnesota.

Job Number: _____

Surveyed For Port Authority


Date July 29, 1987

Scale 1" = 50'

Description: (Contains - 13,750 sq. ft. or 0.316 Acres)

The South 55 feet of Lot 2,
 Block 2, Riverview Industrial
 Park No. 1, Ramsey County,
 Minnesota.

By _____
 REGISTERED LAND SURVEYOR
 Mn. Registration No. 10459

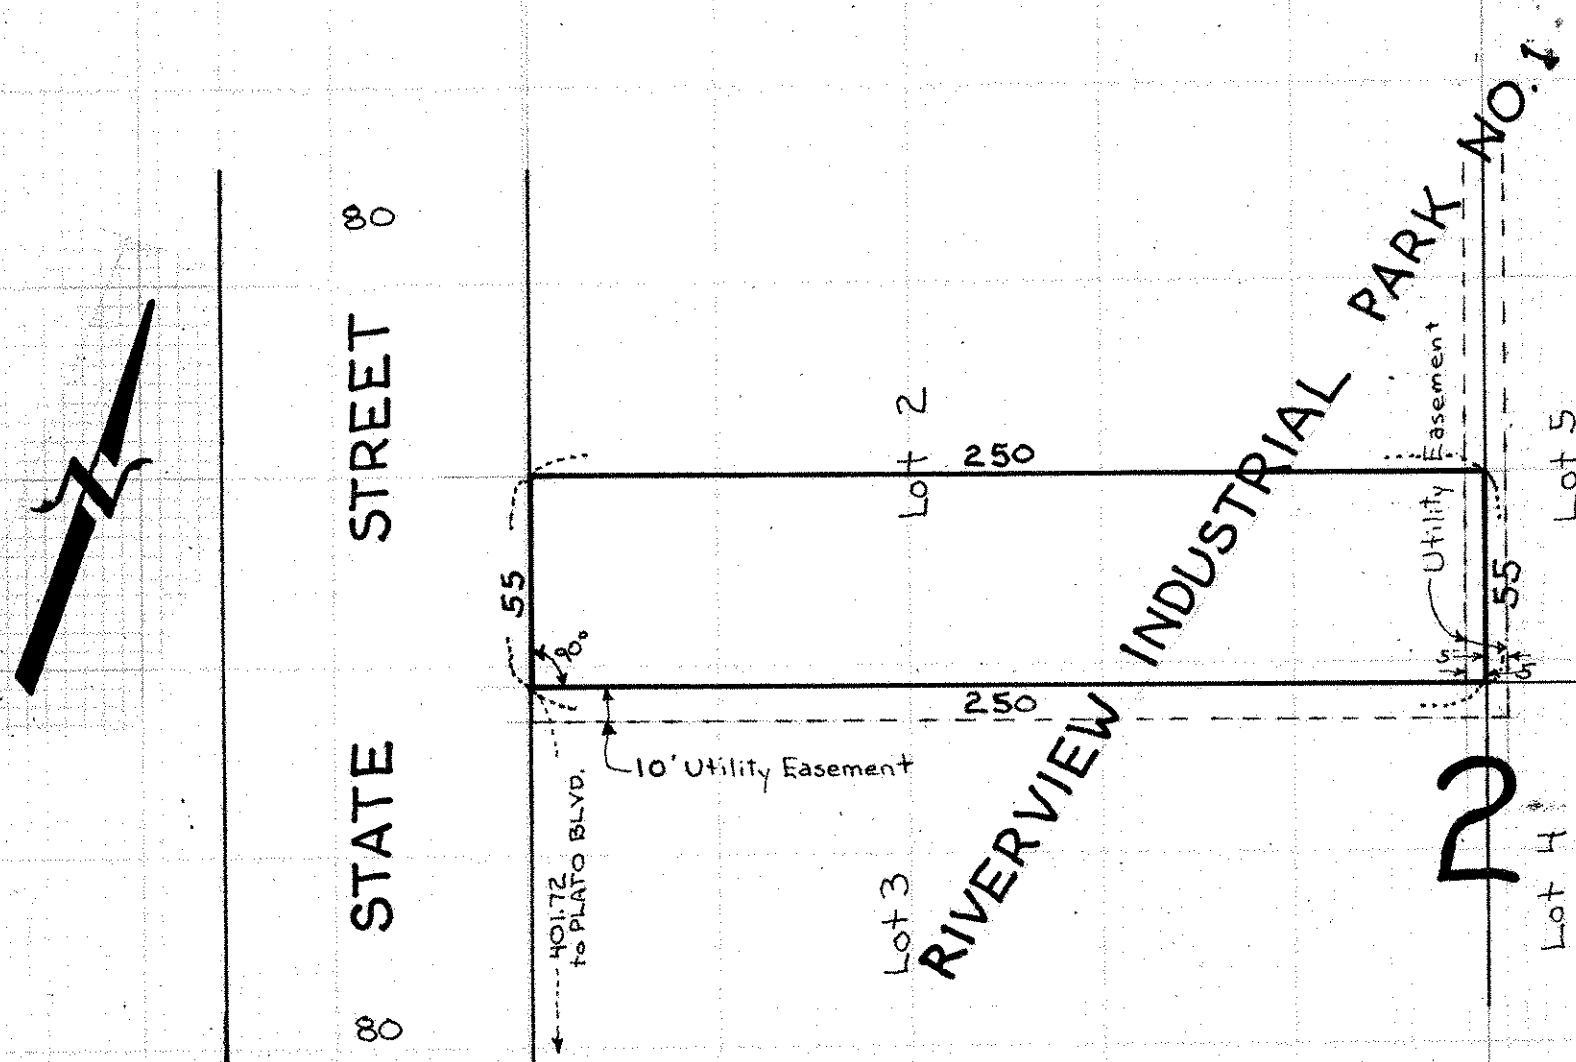

No corners set
 Easements as per plat only are shown.