



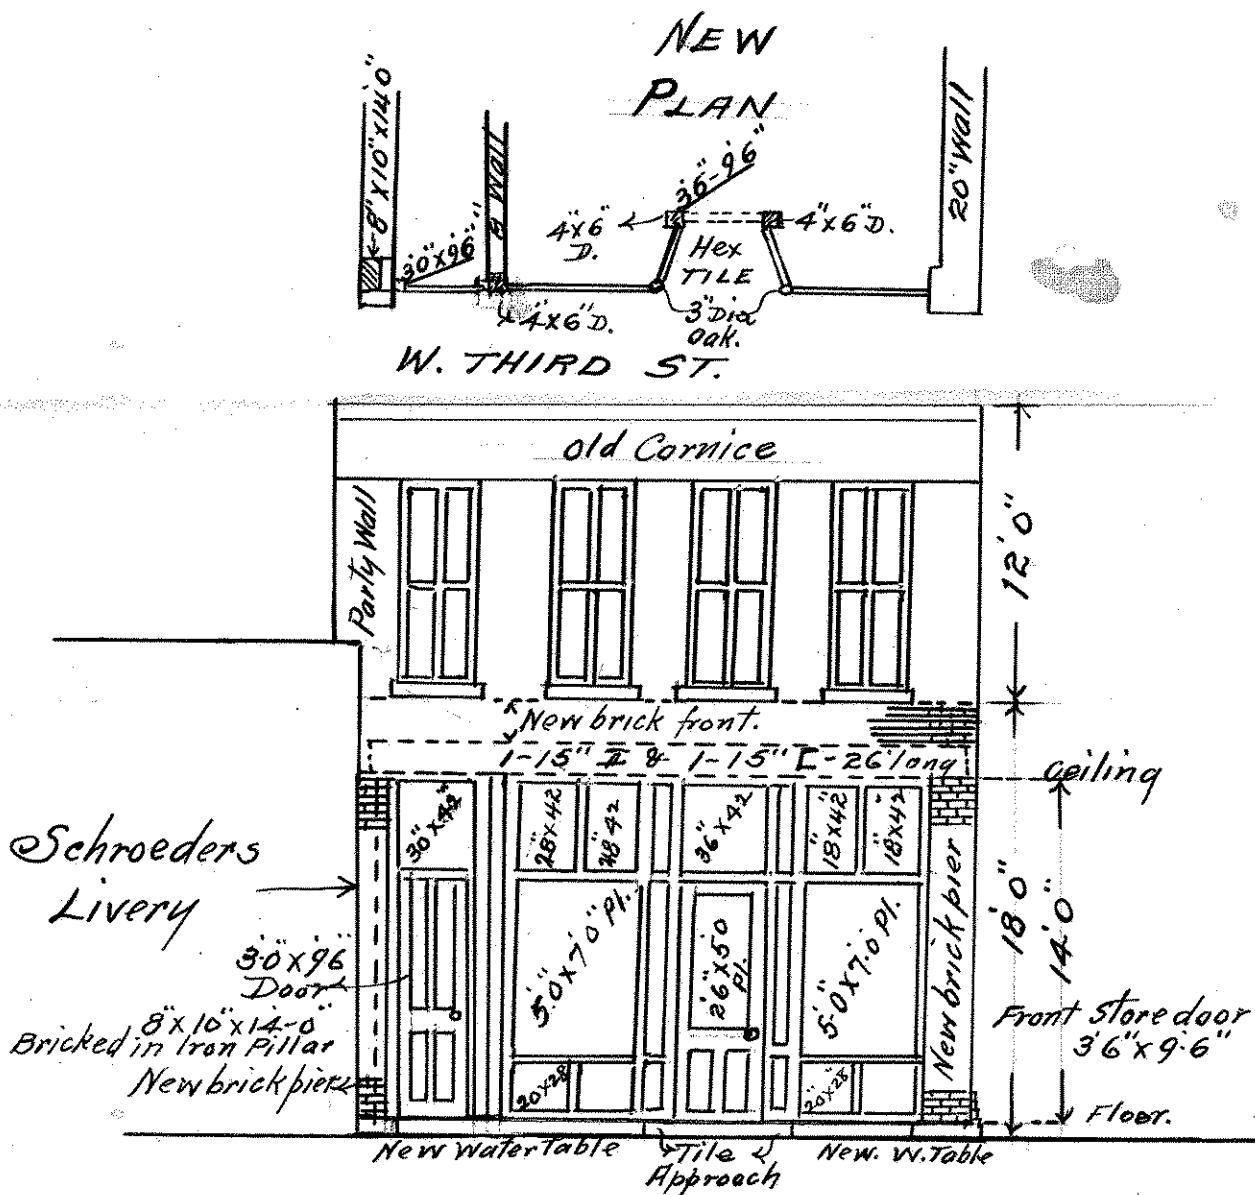

PROPOSED FRONT NO 170. W 3rd ST.
Elevation
Scale 1/8 inch per ft.

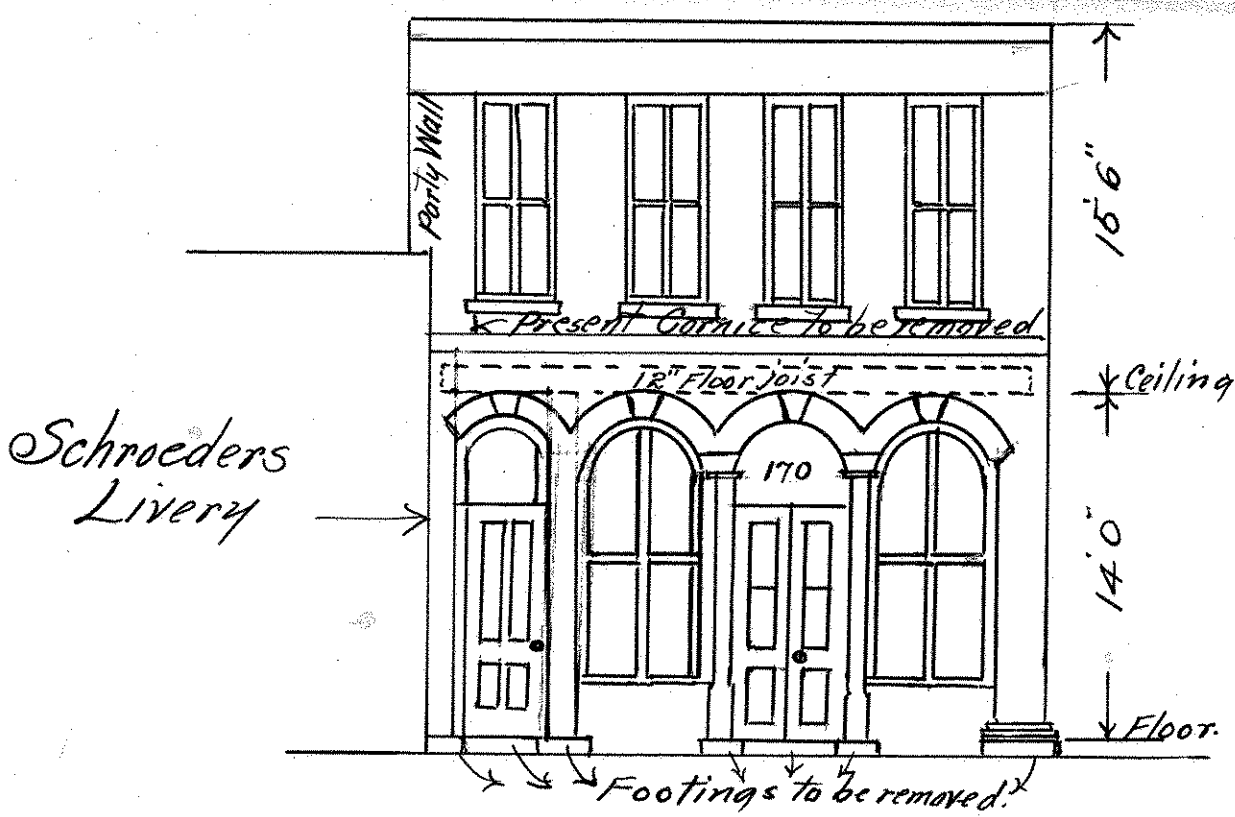

PRESENT FRONT NO 170 W 3rd ST.
Elevation.
Scale 1/8 inch per foot.

