


PART OF GOV'T. LOT 7
SEC. 6, T. 28, R. 22

Scale 30 Feet pr. inch

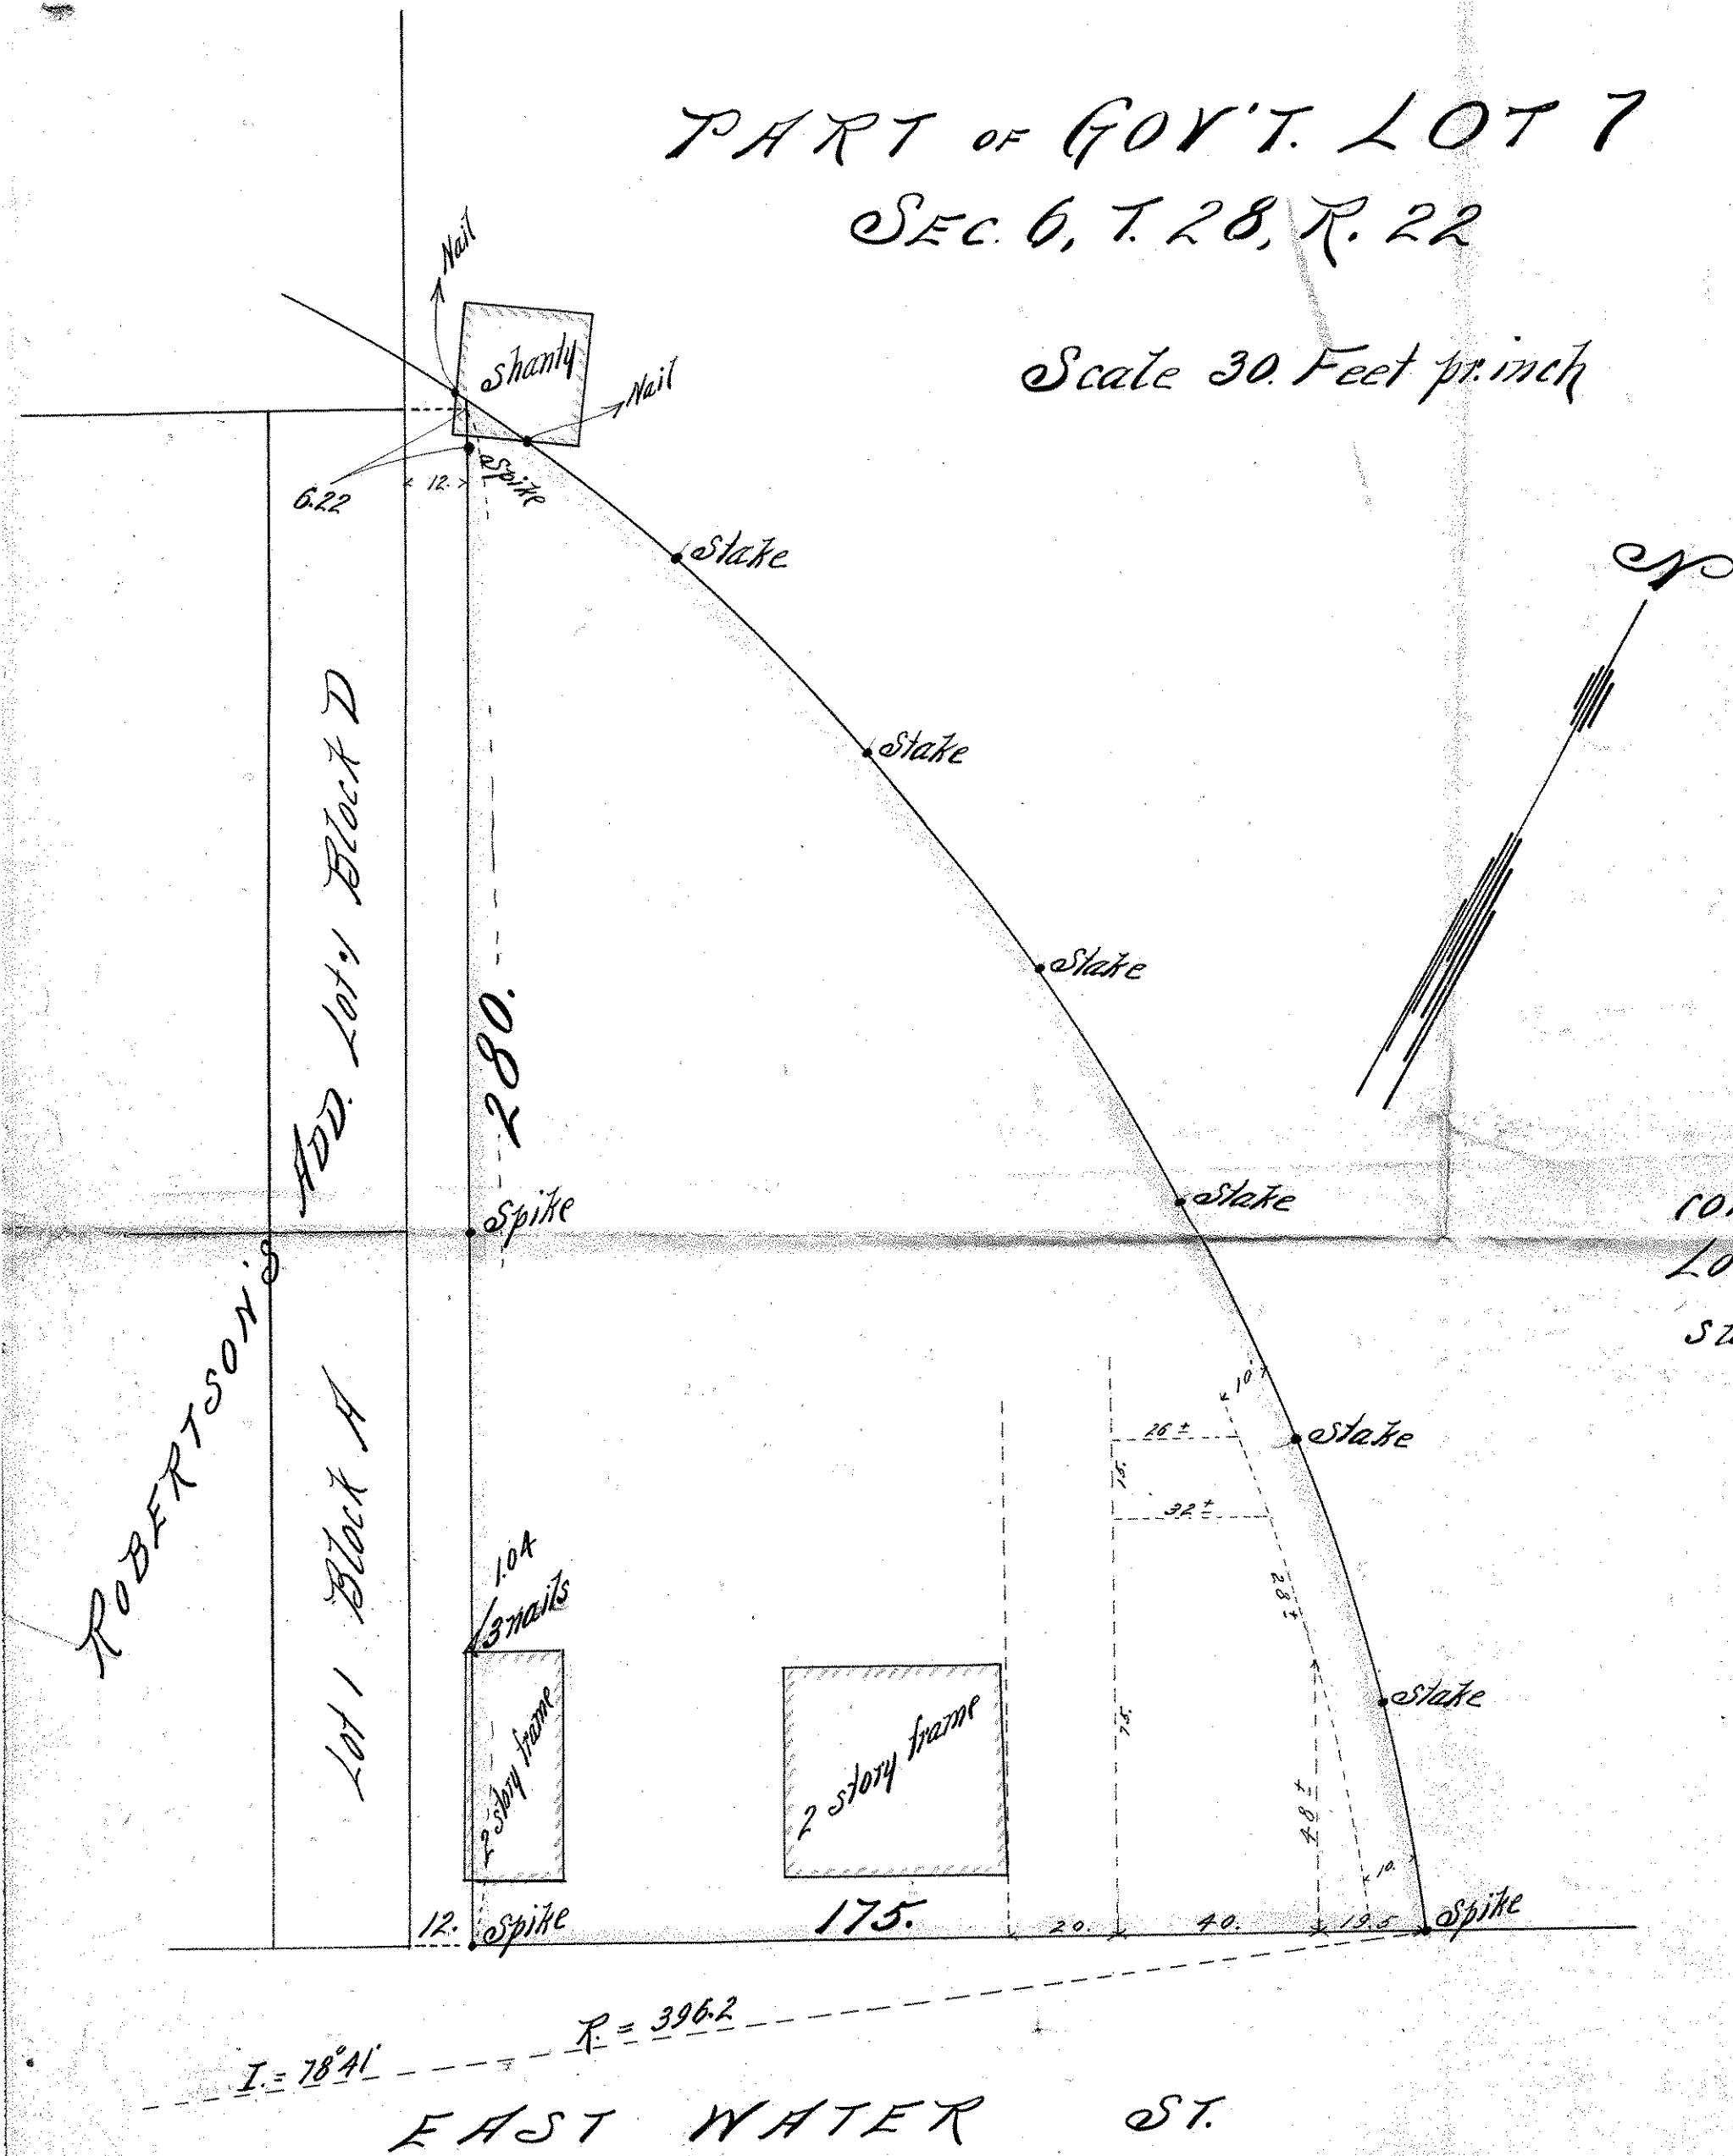

St. Paul Minn. Jan. 18th 1904

I hereby certify that this diagram
correctly represents "PART of Gov't.
Lot 7. SEC. 6, T. 28. R. 22," as
surveyed by me this day.

John B. Irvine
County Surveyor
Room 16 Court House.