LOCATION OF HOUSE KNOWN AS
49½ KENTUCKY ST. ON
GOV'T LOT 4. SEC. 5. T. 28. R. 22.
VICTORIA JERURSAL OWNER.
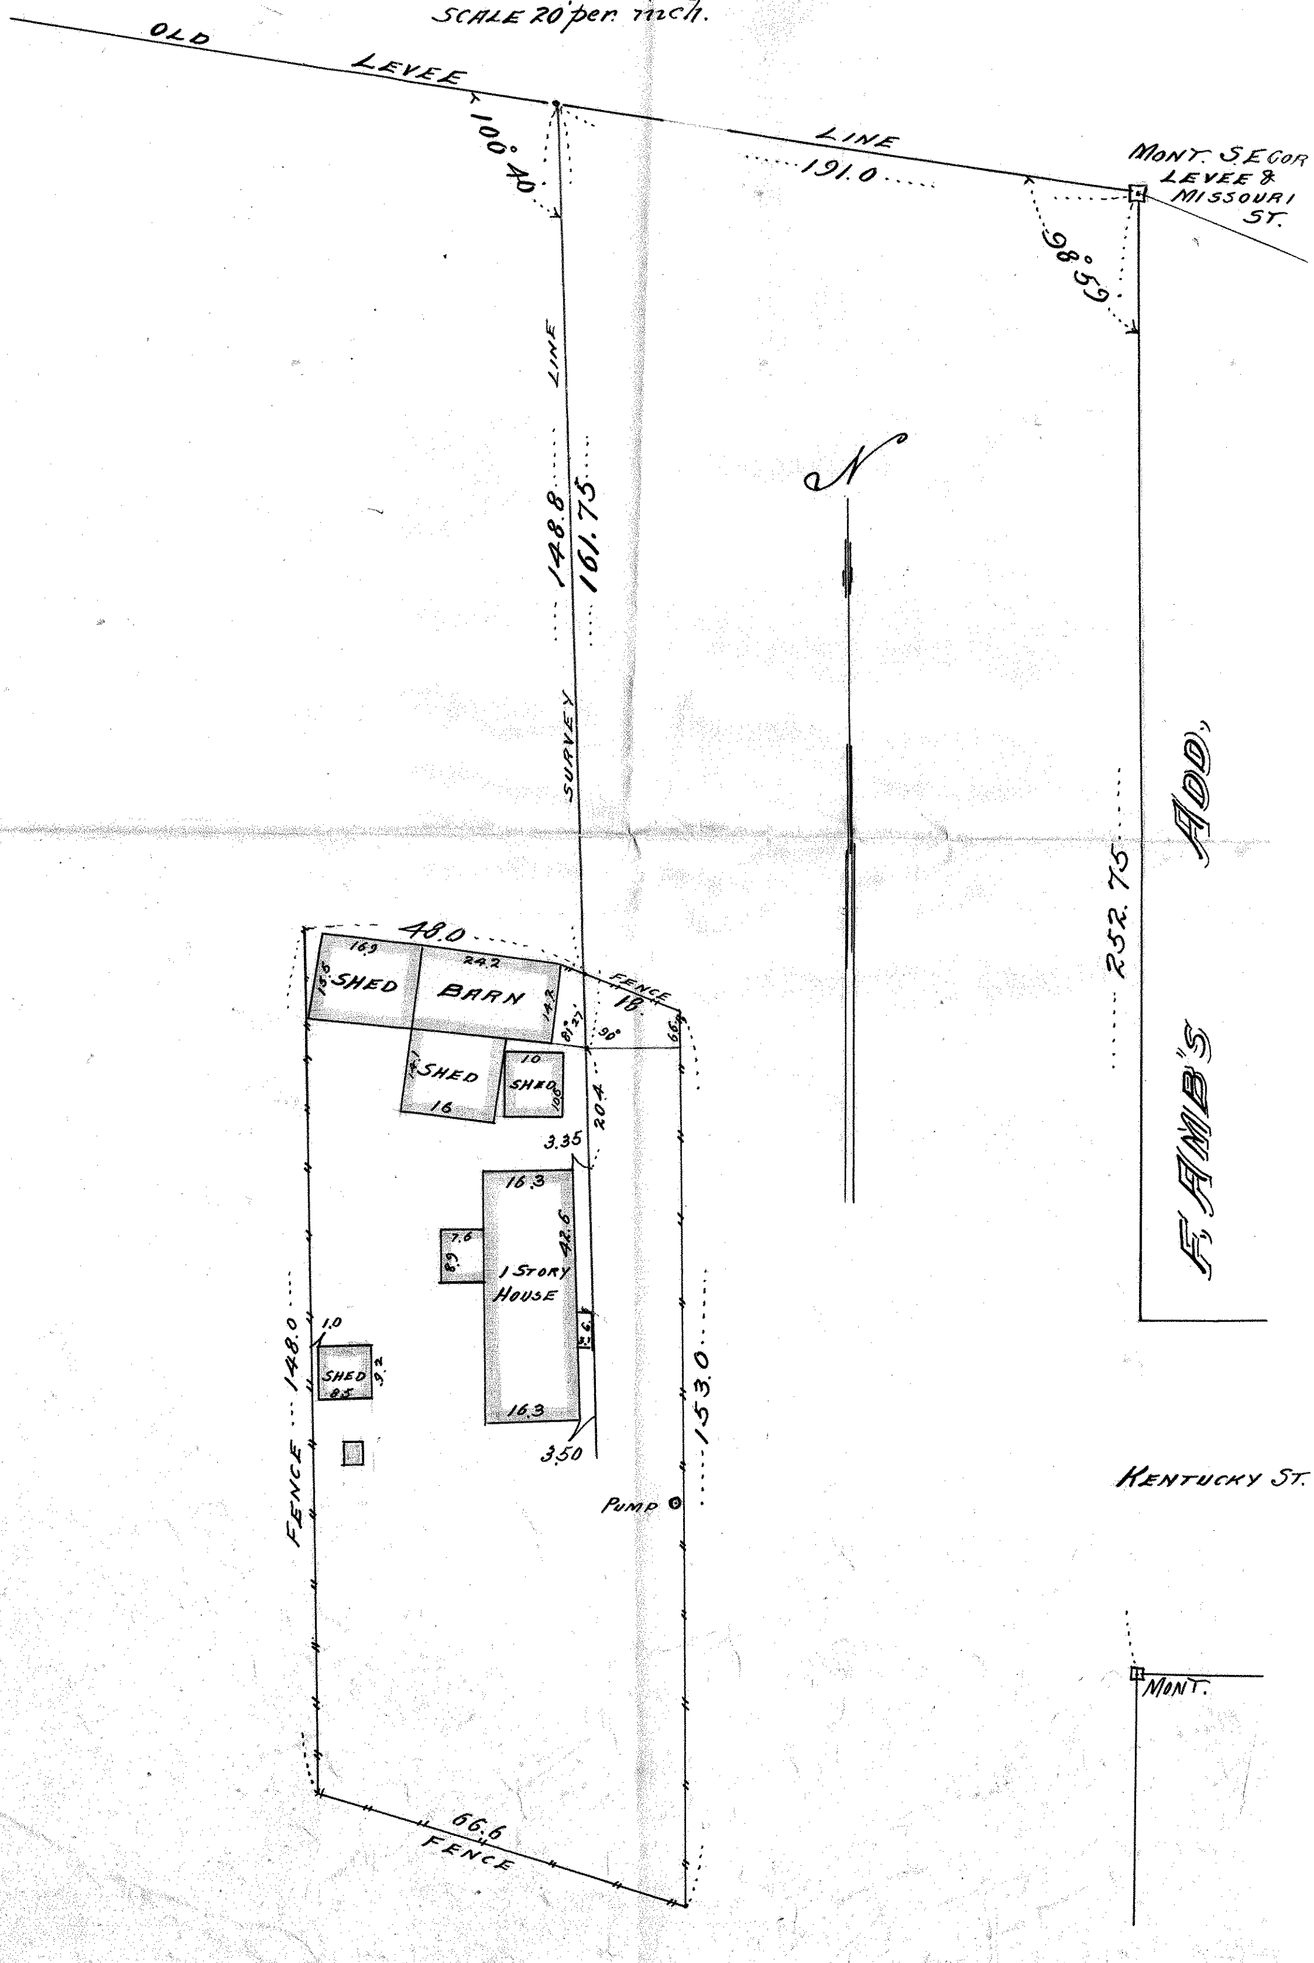
JOHN B. IRVINE SURVEYOR
MAY 16-1908
SCALE 20' per inch.