

MISSISSIPPI
RIVER

St. Paul Minn


June 28th 1902

I, hereby certify that this diagram
correctly represents the acreage of the
Mintzer Estate in Lot 4, Sec. 5, T.28, R.22
lying West of the West line of
F. Amb's Add.

John B. Irvine
County Surveyor

Room 16 Court House.

200 feet pr. inch.

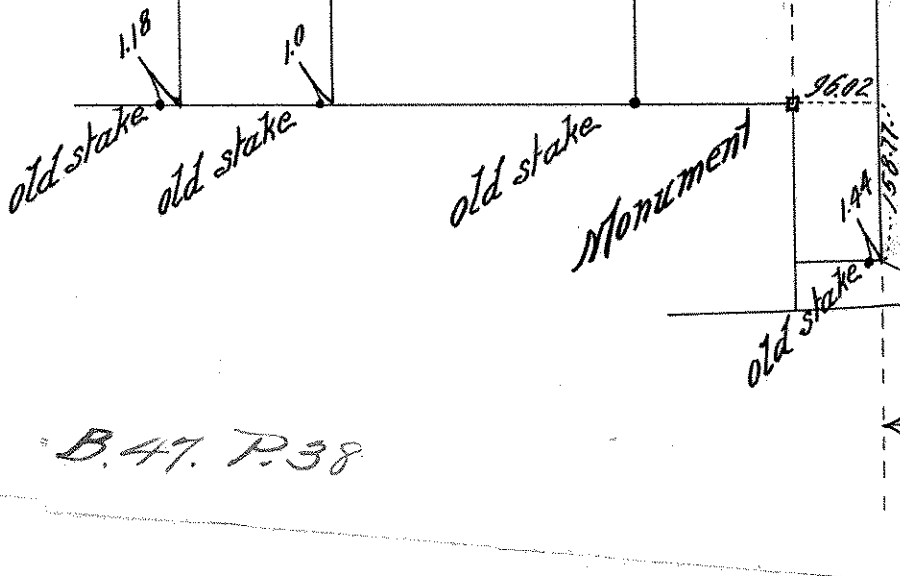

B. 47. P. 38

JOHN B. IRVINE
Co. Surveyor, R. 16, Court House