


PART OF LOT 4
SECTION 5, TOWN 28 RANGE 22,
Mississippi River.

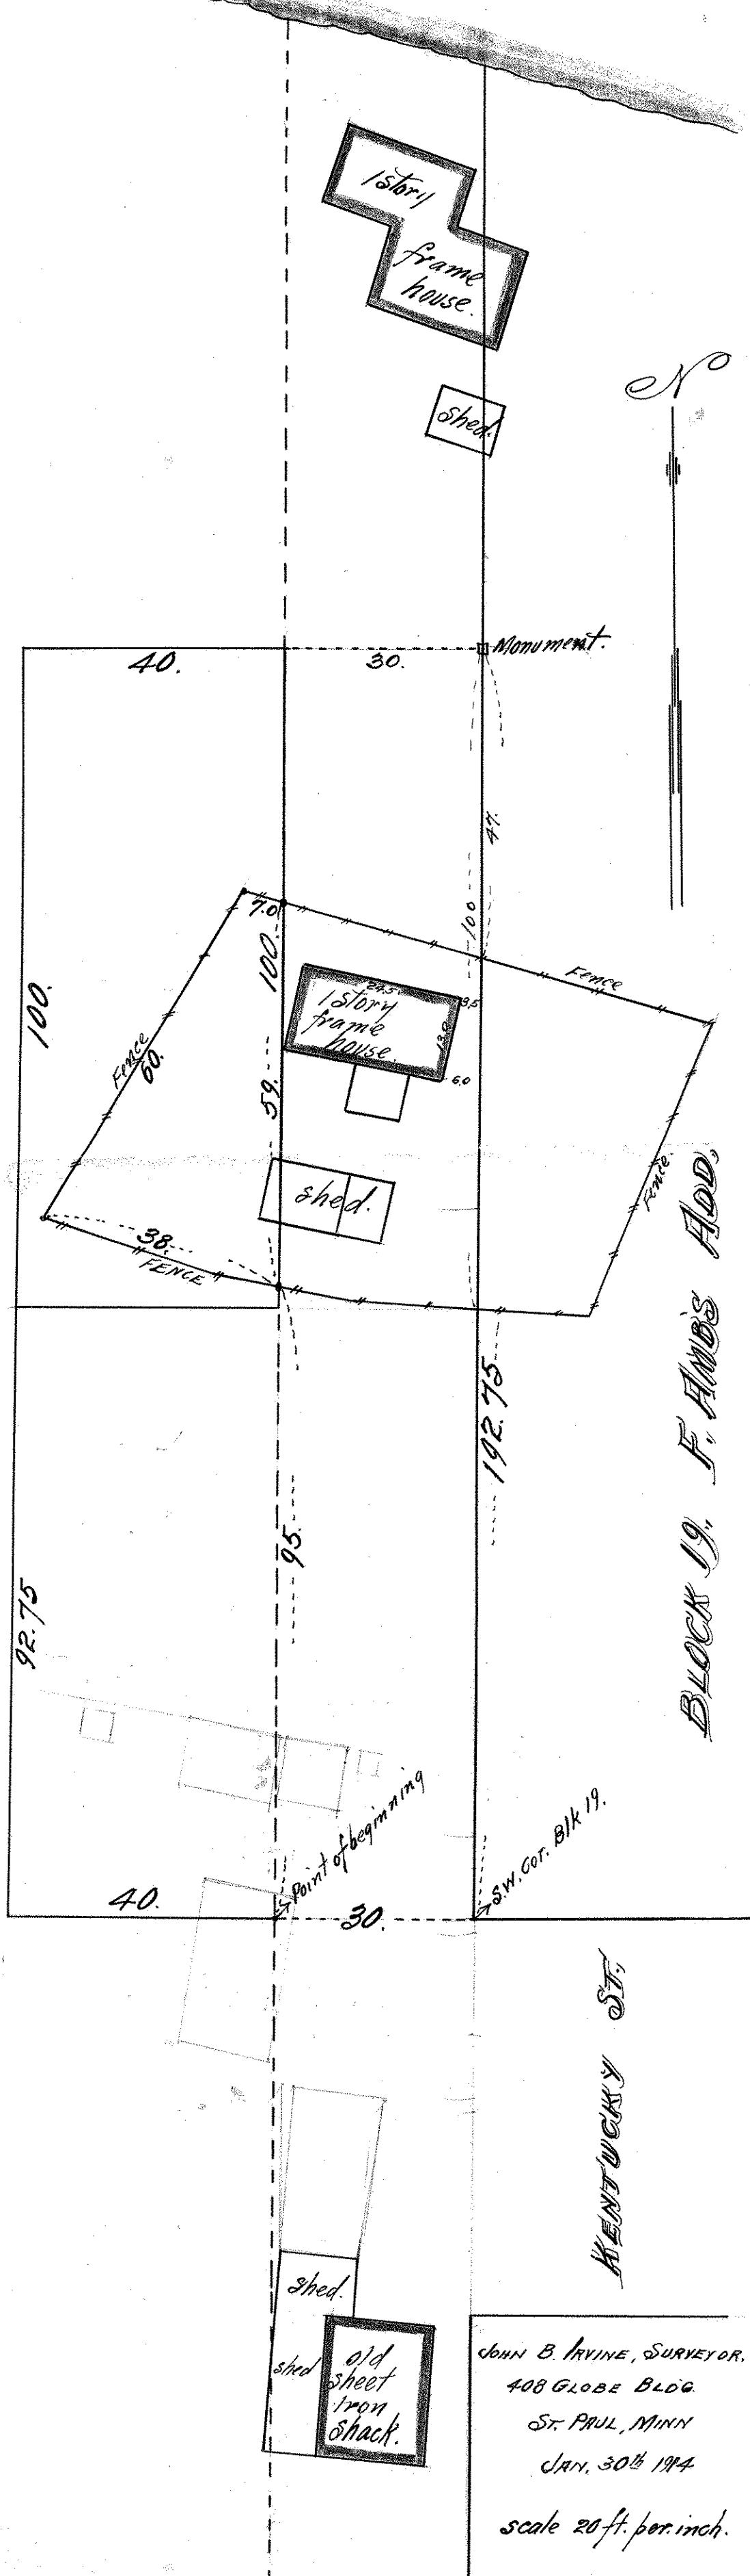

BLOCK 19, F. AMES ADD.

KENTUCKY ST.

JOHN B. IRVINE, SURVEYOR,
408 GLOBE BLDG.
ST. PAUL, MINN
JAN. 30th 1914
scale 20 ft. per inch.