


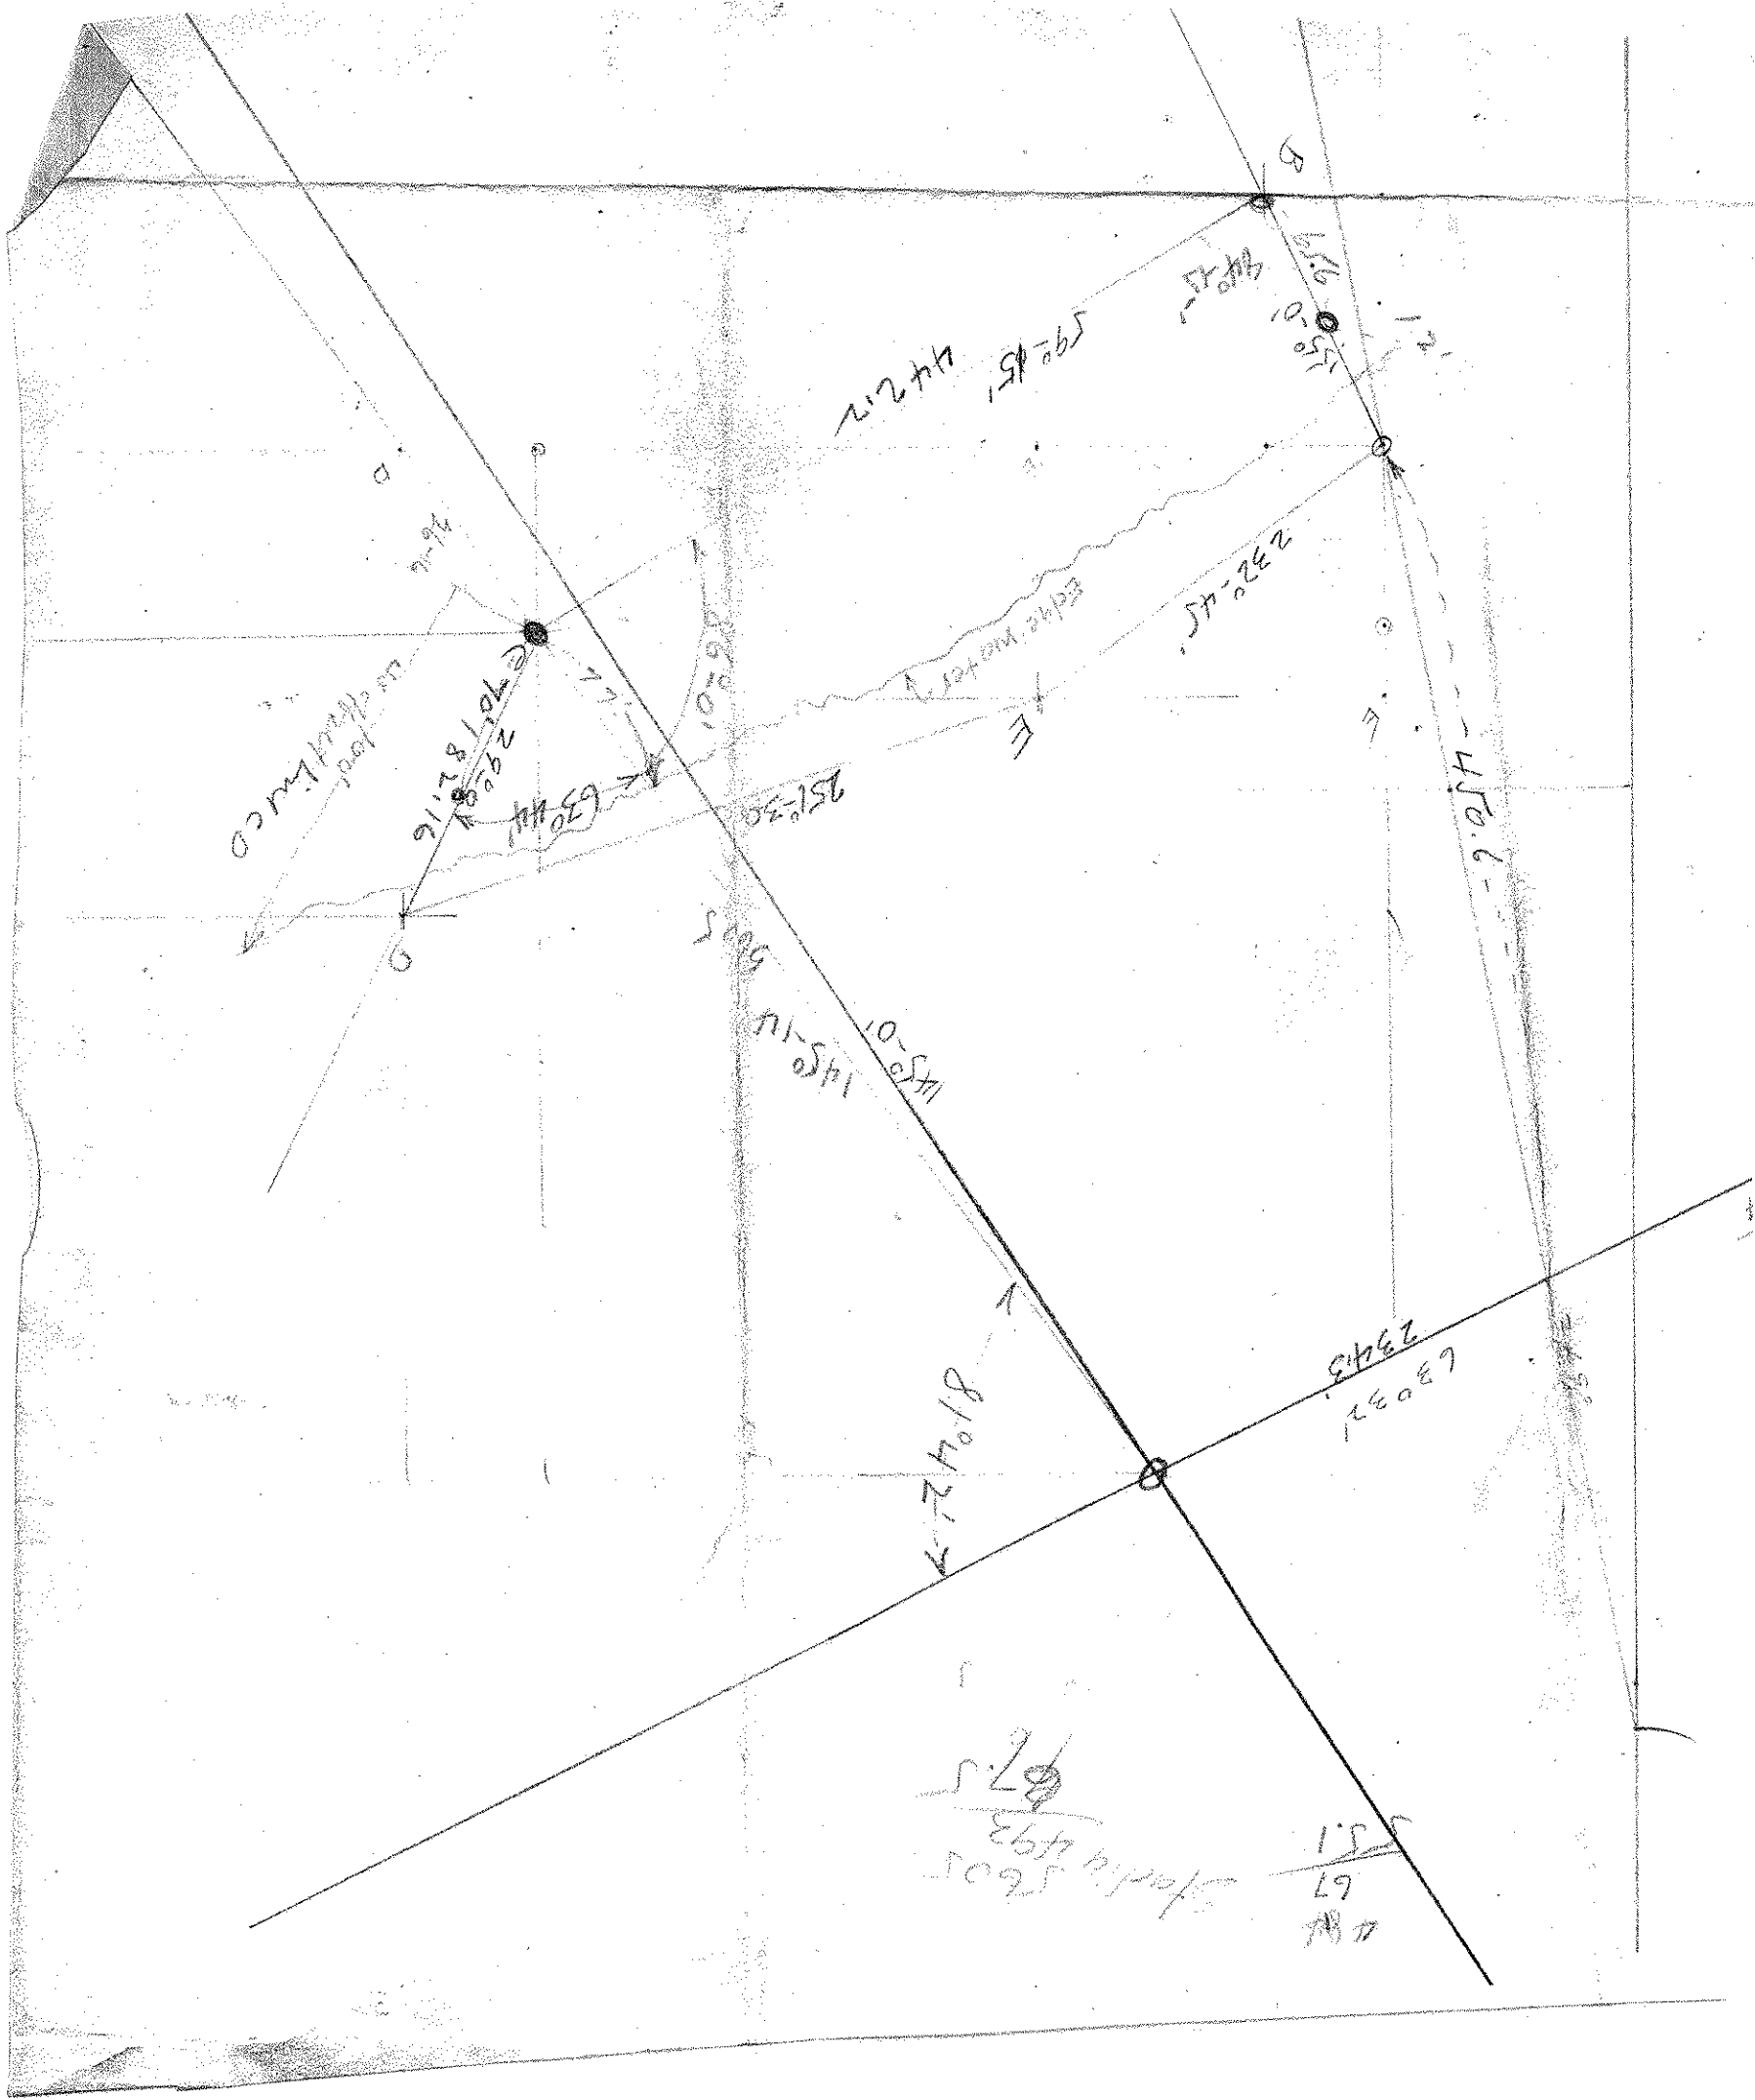

5.26
87.5
560.5
509.5
1.55
67
78.7