

CHARLES O. GEORGI COMPANY

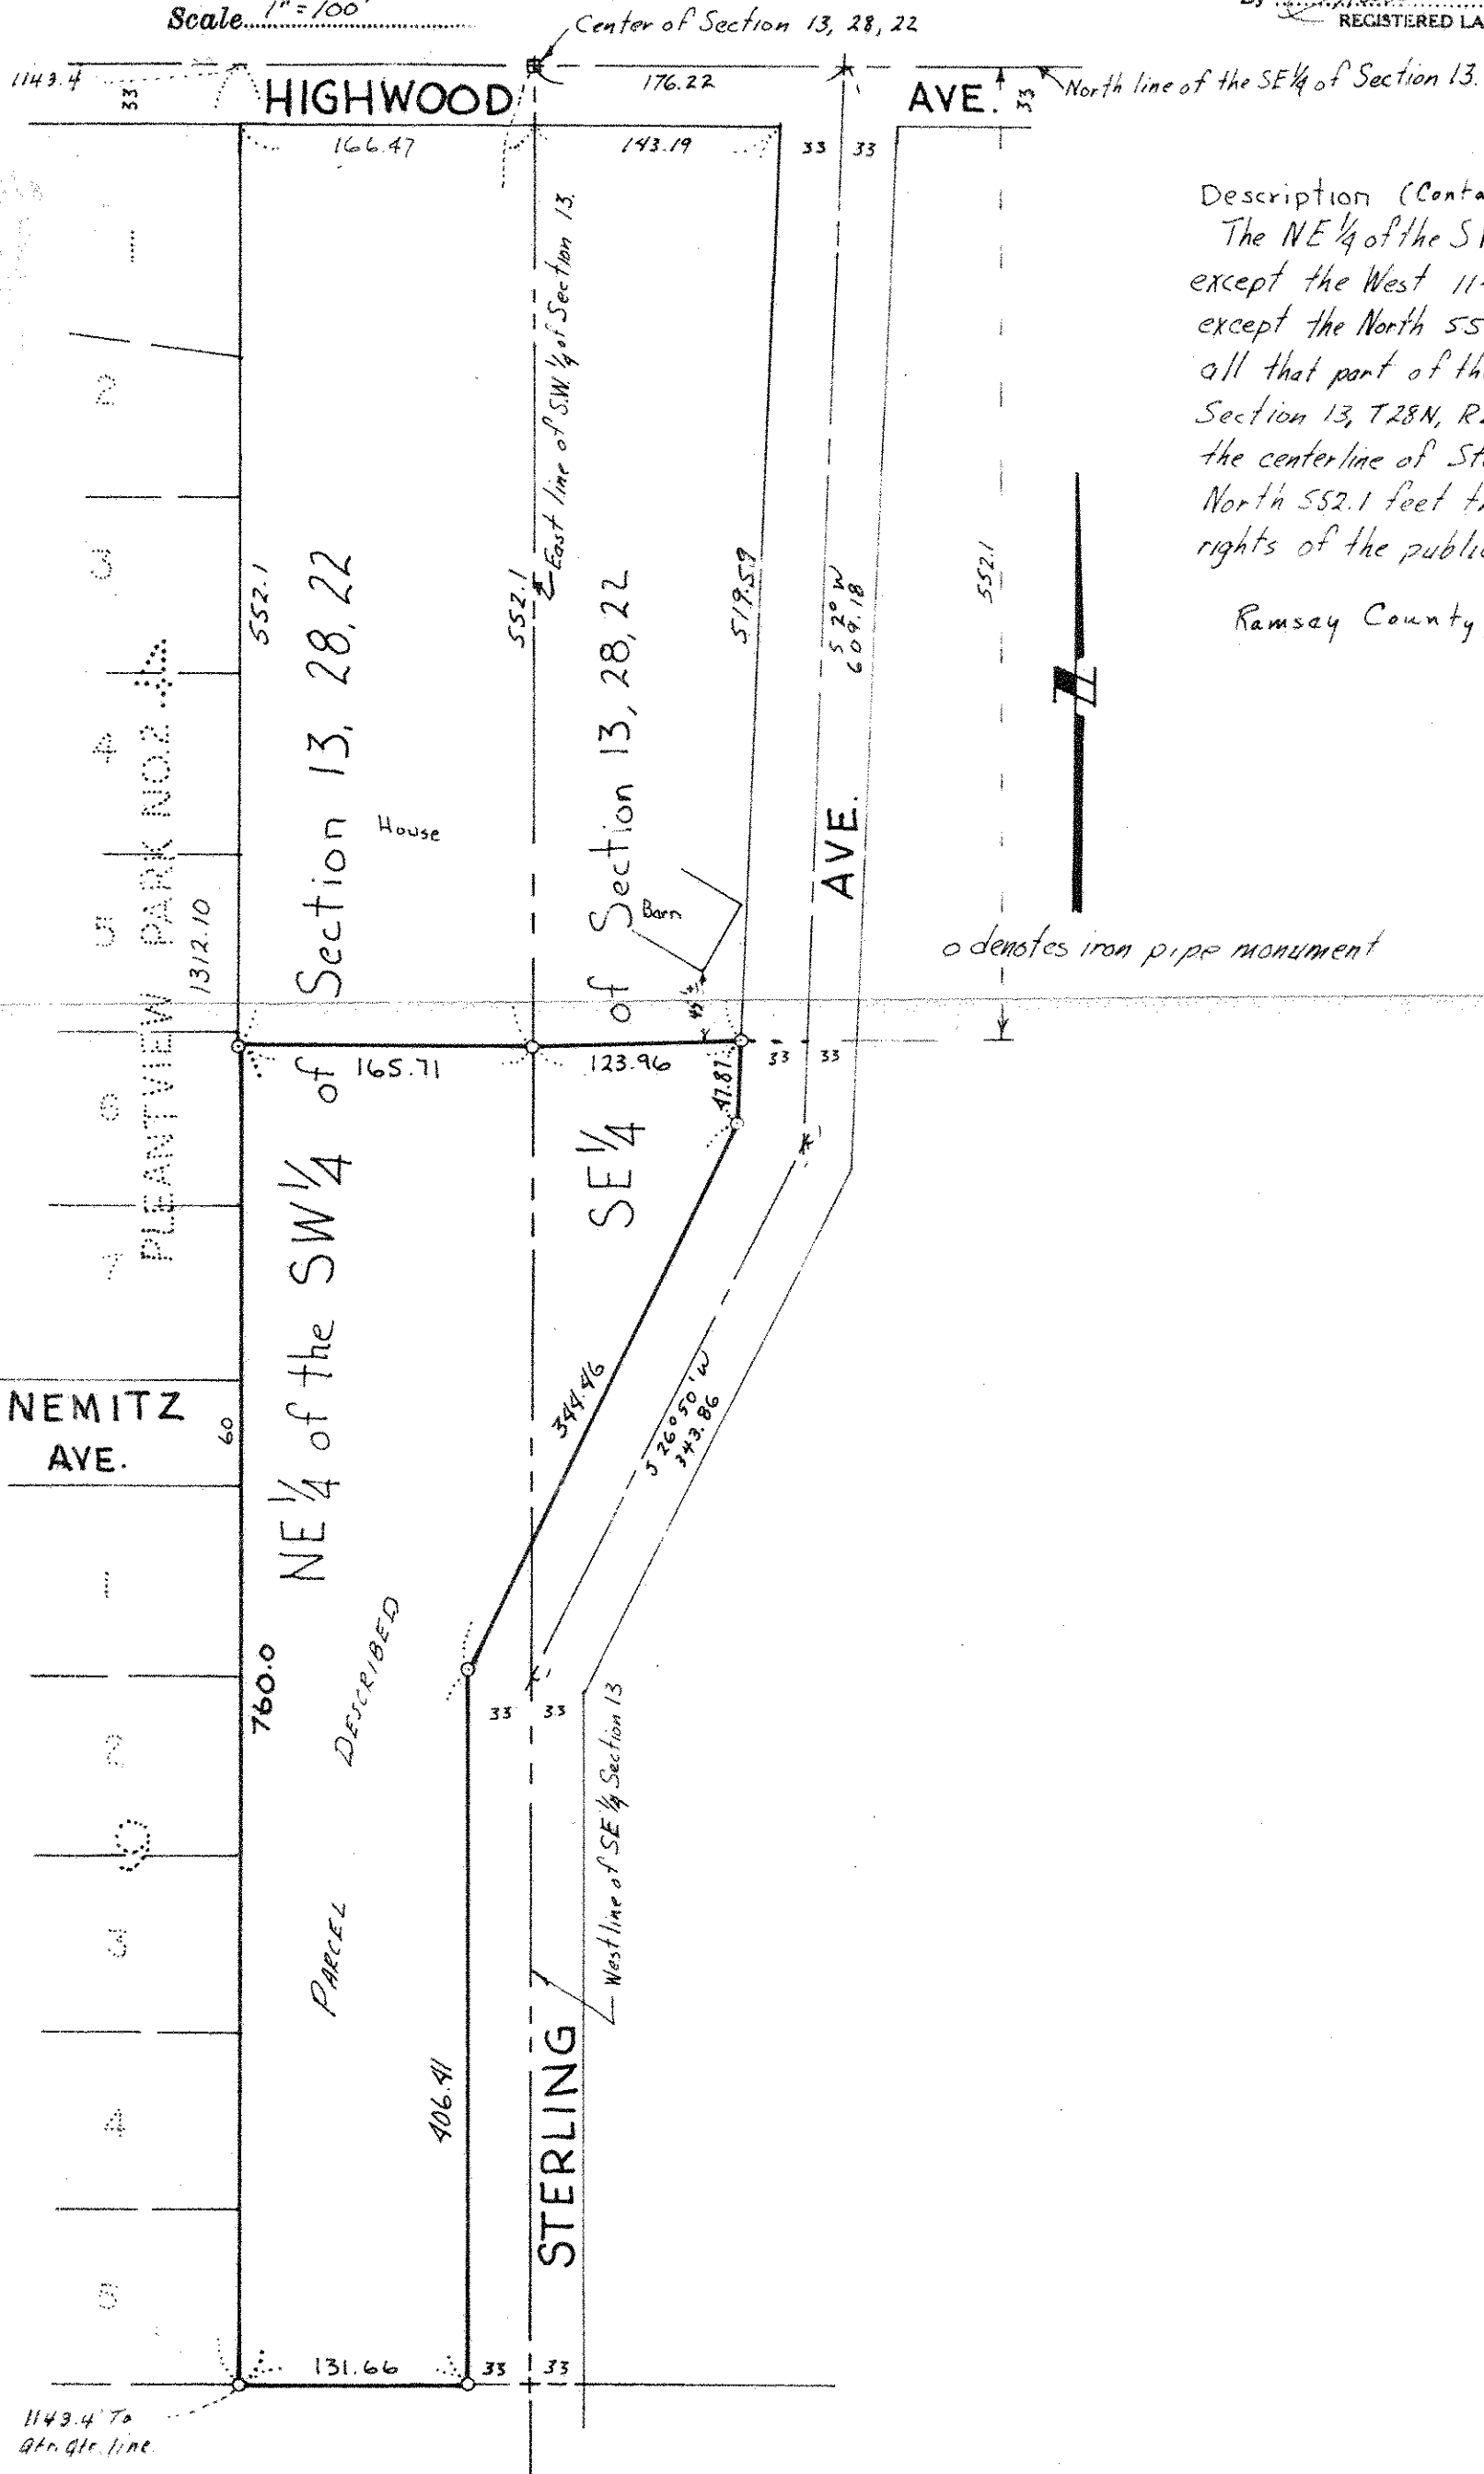
2215 West County Road B

Saint Paul, Minnesota 55113

REGISTERED CIVIL ENGINEER AND LAND SURVEYOR

**Certificate
of Survey**

I Hereby Certify that this plat shows a survey made by me of the property described on this plat, and that the corners are correctly placed as shown, and that all locations have been correctly shown.

Surveyed For *Danna Properties*Date *Aug. 1975*Scale *1"=100'*By *Charles O. Georgi*
REGISTERED LAND SURVEYOR

Description (Contains 1.00 acres, more or less)
The NE 1/4 of the SW 1/4 of Section 13, T28N, R22W except the West 1143.4 feet thereof and except the North 552.1 feet thereof; and all that part of the NE 1/4 of the SE 1/4 of Section 13, T28N, R22W lying Westerly of the centerline of Sterling Ave. except the North 552.1 feet thereof subject to the rights of the public in Highway Ave.

Ramsay County, Minnesota