


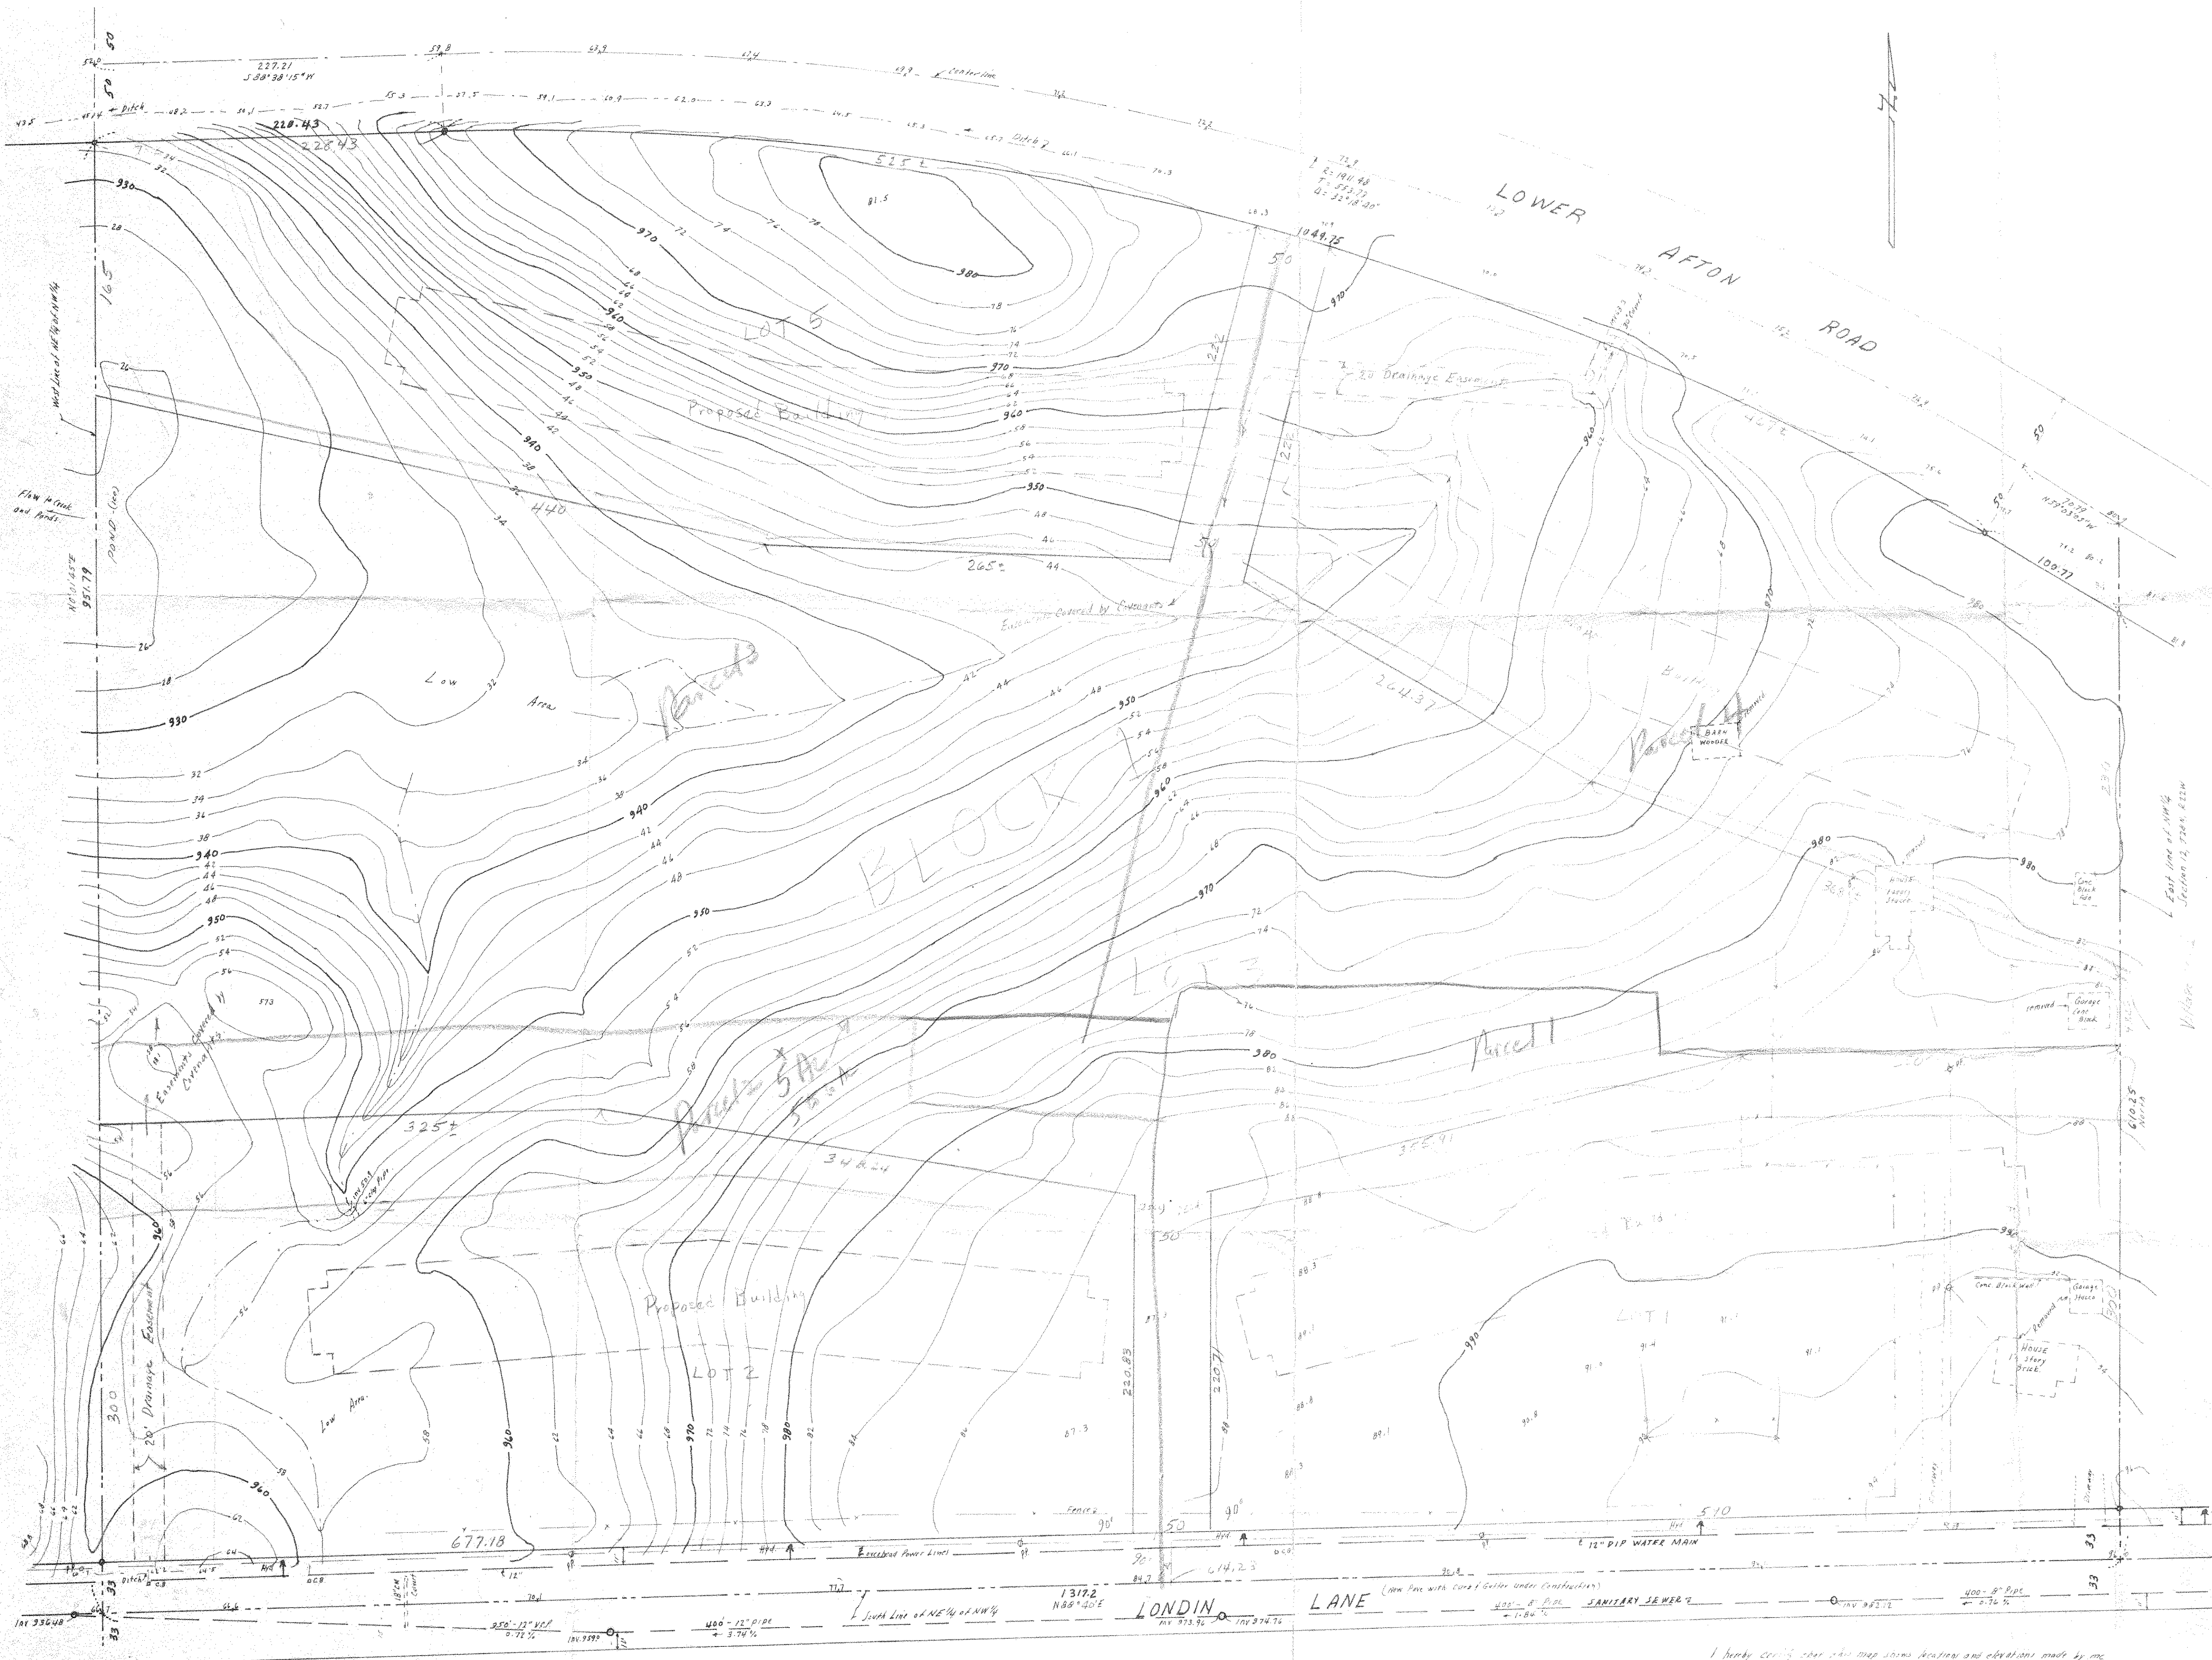

DESCRIPTION:
All that part of the NE 1/4 of the NW 1/4 of Section 12,
South line of Lower Afton Road.
Subject to London Lane and easements of record.
Contains 24.81 Acres, more or less.

TOPOGRAPHY:
All elevations are Village Datum & U.S.G.S. Datum.

BM = 990.79 Flow line of South end of Culvert under
Lower Afton Road, Approx 80' SE of Intersection
of London Lane & Lower Afton Road.

o Denotes Iron Pipe Monument
+ P.P. Power Pole.
Elev. Denotes Elevation 990.0 where shown.
Utilities: See Arch. tests plan
as approved by Village of Maplewood.

Zoning:
Planned Unit Residential Development was
approved by Village Council 12/17/72.

1/14/73 Approval requested to plat the 5 lots
as shown herein.
See Arch. tests plan for position of
utility lines.
3-5-73

DRAWN BY:
CONDOR CORPORATION
439 Oak Grove
Minneapolis, Minn
554-0415

PRELIMINARY PLAT
TOPOGRAPHY MAP
CONNEMARA
VILLAGE OF MAPLEWOOD
RAMSEY COUNTY, MINN.

SCALE 1" = 50'

CHARLES A. GEORGI COMPANY
CIVIL ENGINEERING & LAND SURVEYING
3092 N. Lexington Ave., St. Paul, MN 55112
453-4408

February 1, 1973
March 6, 1973 - Revised
1/10/73 - Revised

I hereby certify that this map shows locations and elevations made by me
or under my supervision for the property described herein and the same are
correctly shown.

Registered Land Surveyor #3900

1/10/73

1/10/73