

FROM THE OFFICE OF

CHARLES O. GEORGI COMPANY

2215 West County Road B

Saint Paul, Minnesota 55113


REGISTERED CIVIL ENGINEER AND LAND SURVEYOR

**Certificate
of Survey**

I Hereby Certify that this plat shows a survey made by me of the property described on this plat, and that the corners are correctly placed as shown, and that all locations have been correctly shown.

Surveyed For *Water Dept.*Date *Oct 1968*Scale *1" = 100'*By *Charles O. Georgi*
REGISTERED LAND SURVEYOR**Description:**

The North 200 feet of the South 900 feet of the West 550 feet
of the SW $\frac{1}{4}$ of SW $\frac{1}{4}$ of Section 12, T28N, R22W
Subject to McKnight Road.

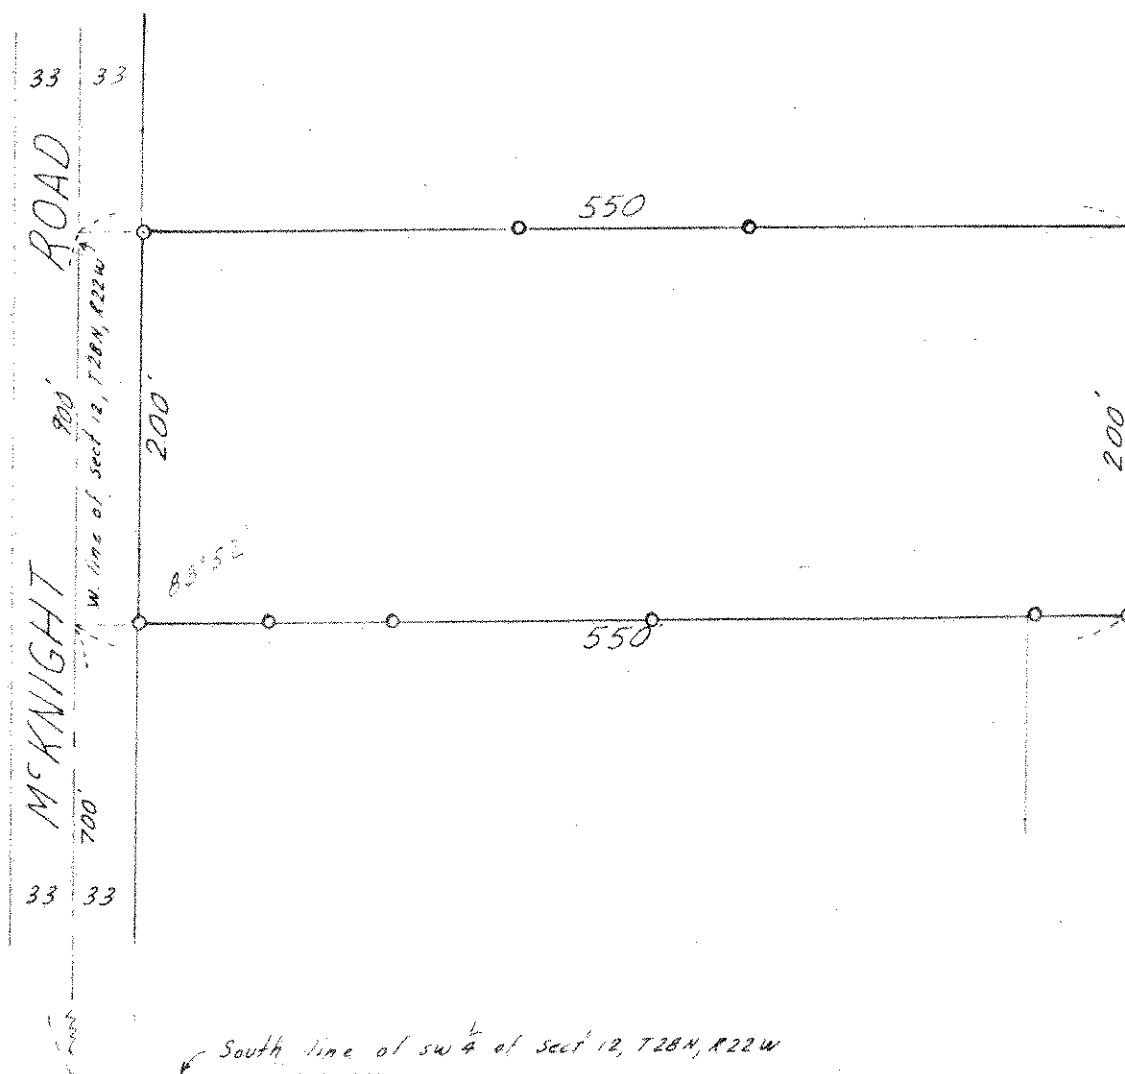

○ Denotes Iron Monument