

PLAT OF SURVEY

Appl. 29968

FRANCIS E. YOUNG

The North 218 feet of the East $\frac{1}{4}$ of the North half of NE $\frac{1}{4}$ of the SE $\frac{1}{4}$ of Section 11-28-22. Subject to rights of the public in existing Streets

No 503 South Mc Knight Road, St. Paul, Minnesota

SCALE: 1"=30'




T. J. WELCH
Registered Surveyor
738 Surrey Ave.
ST. PAUL, 6, MINN.
TEL. PR 6-0640
11-7-1959

MAIL AND ROAD

North Line of the East $\frac{1}{4}$ of the North $\frac{1}{2}$ of NE $\frac{1}{4}$ of SE $\frac{1}{4}$ of Sec. 11-28-22

SOUTH MC KNIGHT ROAD

East Line of Section 11-28-22

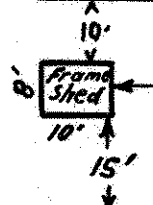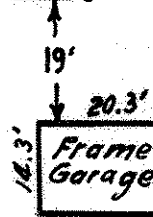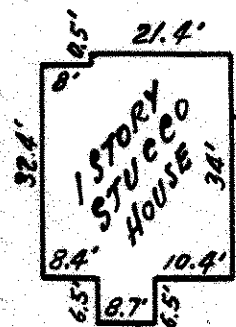

59'

50.5'

60.3'

33'

33'