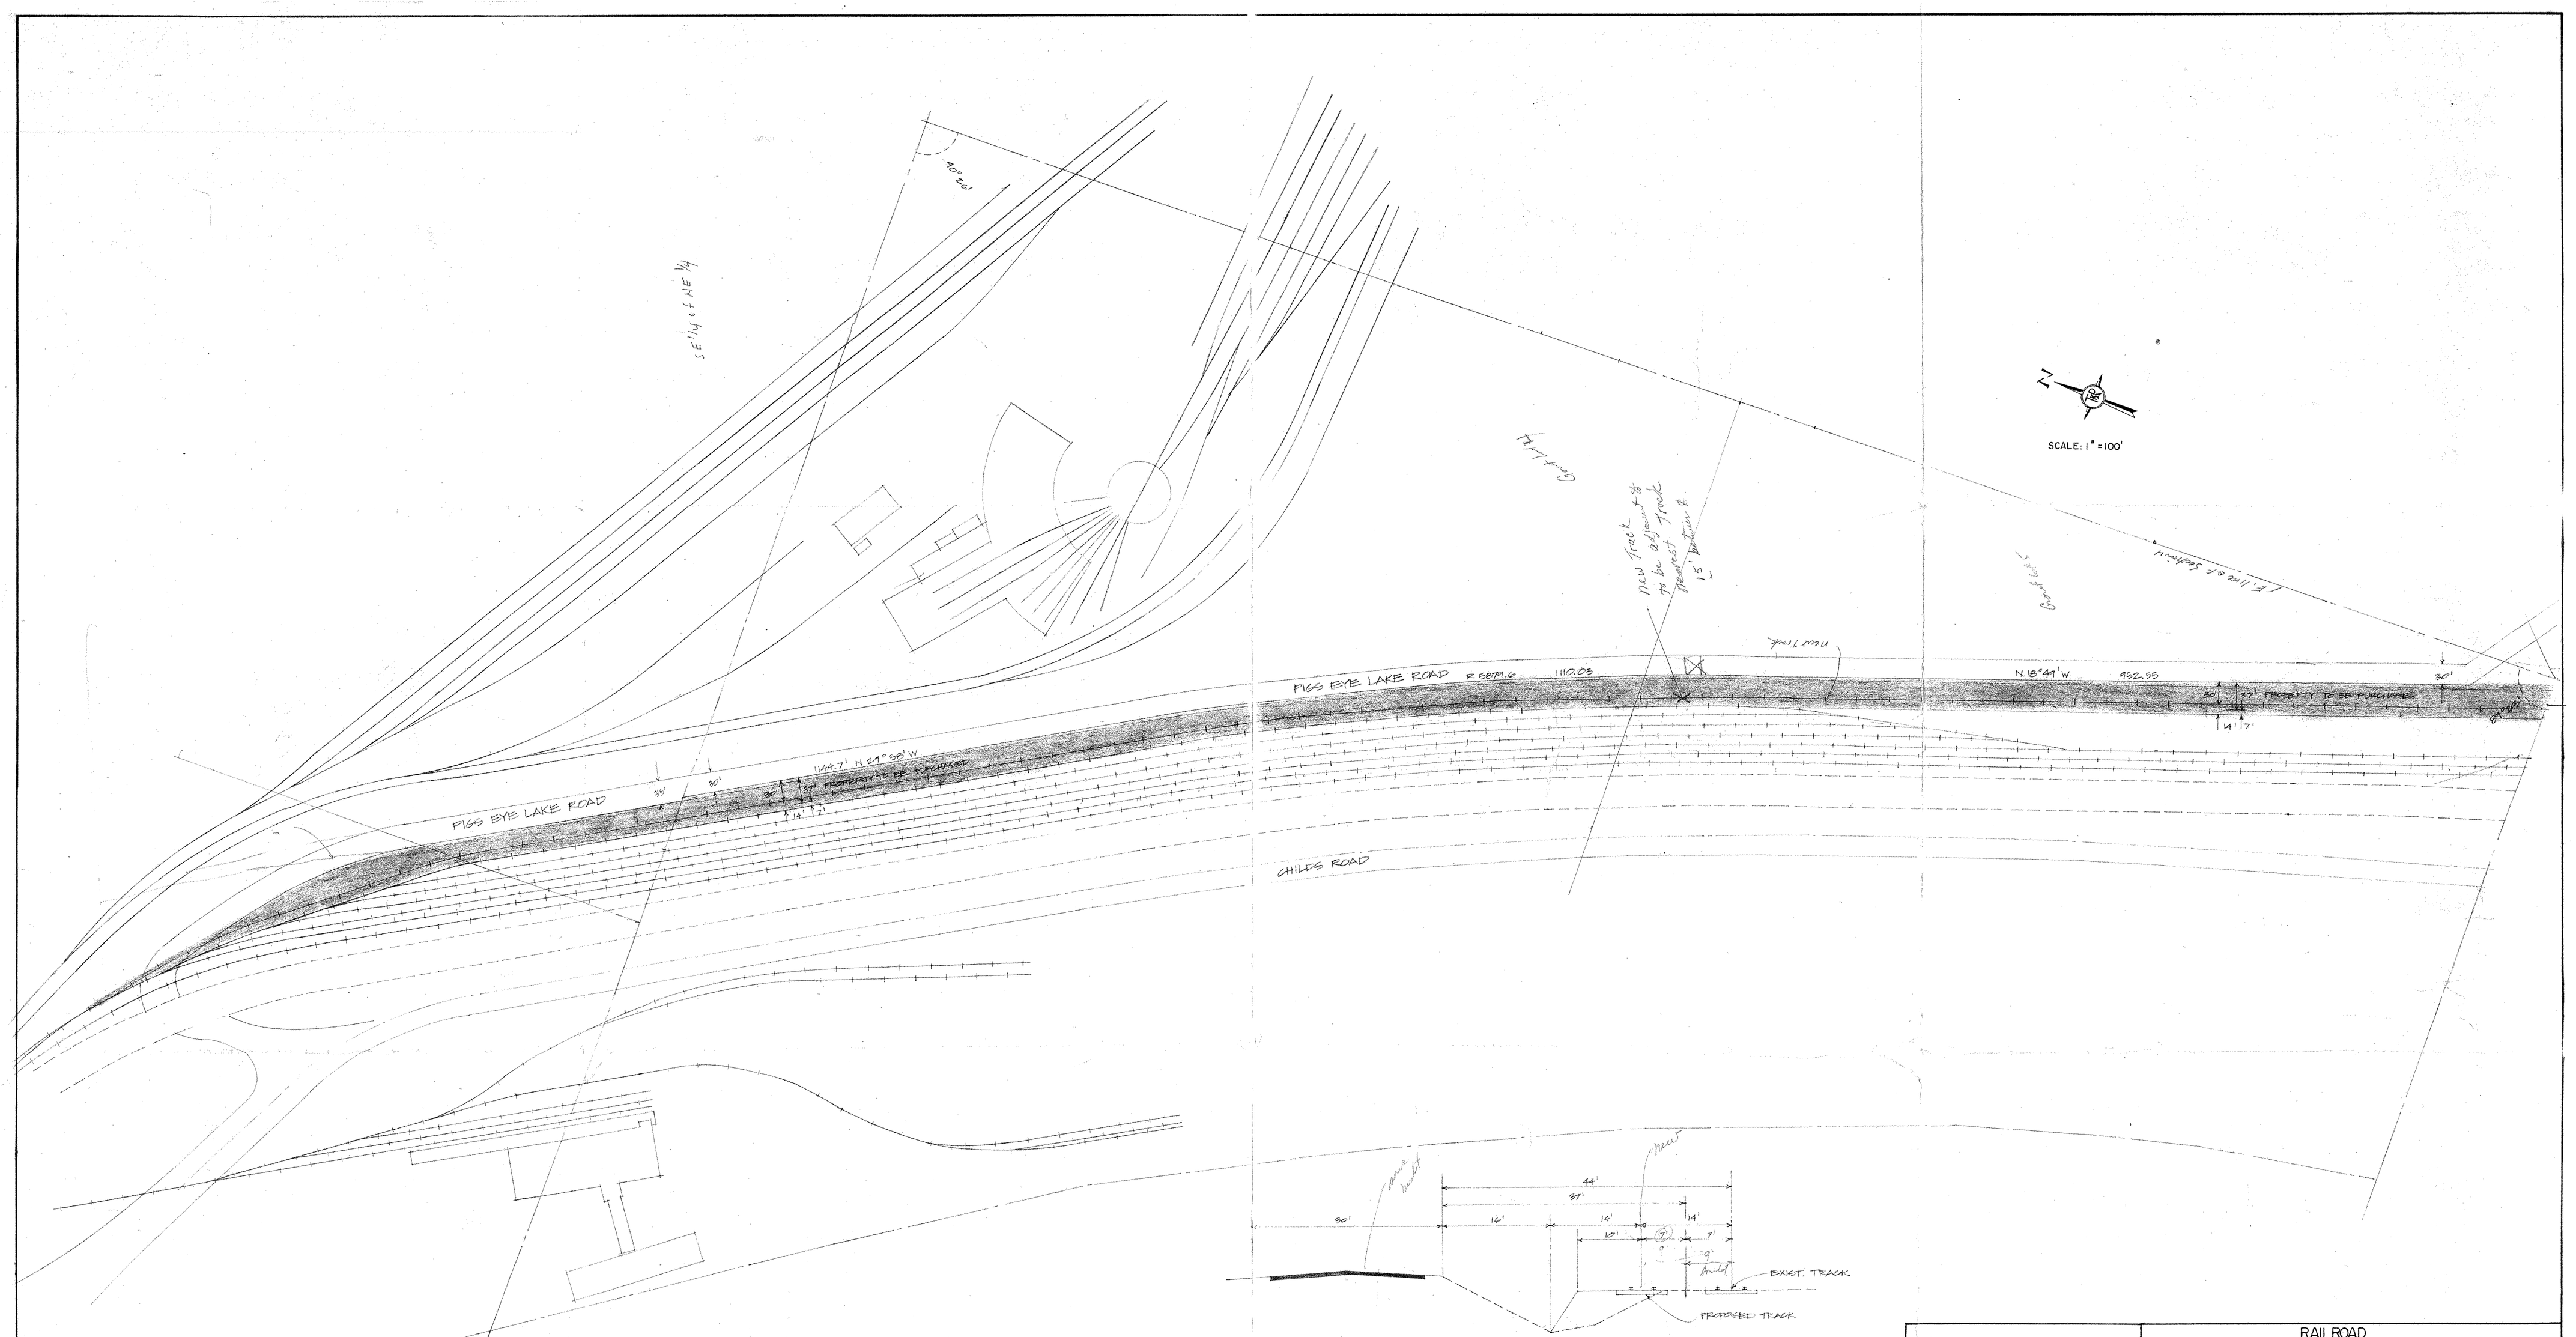

I certify that this plan, specification, or report was prepared by me or under my direct supervision and that I am a duly Registered Professional Engineer under the laws of the State of Minnesota.

Date DECEMBER 16, 71 Reg. No. 837

COM. 5801

DRG. 6

RAILROAD
TO
COAL HANDLING FACILITIES

PORT AUTHORITY
OF THE CITY OF SAINT PAUL

PIGS EYE LAKE AREA

RECOMMENDED FOR APPROVAL _____ CHIEF ENGINEER — PORT AUTHORITY
DATE _____

APPROVED
DATE _____ EXECUTIVE VICE PRESIDENT — PORT AUTHORITY