

FROM THE OFFICE OF

CHARLES O. GEORGI COMPANY

2215 West County Road B

Saint Paul, Minnesota 55113

REGISTERED CIVIL ENGINEER AND LAND SURVEYOR


**Certificate
of Survey**

I Hereby Certify that this plat shows a survey made by me of the property described on this plat, and that the corners are correctly placed as shown, and that all locations have been correctly shown.

Subject to signing final plat

Surveyed For Port AuthorityDate June 1968Scale 1" = 100'

By

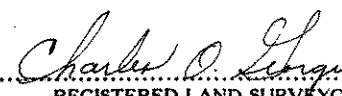

REGISTERED LAND SURVEYOR

Description:

All that part of Lots 1, 2, 3, 10, 11, and 12, Block 12, Town of Brooklynd and the adjoining vacated alley in said Block 12, and that part of vacated Fenton ST.; lying within the following described lines:

Commencing at the Northwest corner of Block 11, Town of Brooklynd, thence Easterly along the Northerly line of said Block 11 and 12 a distance of 328.32 feet to the point of beginning of the parcel of land described, thence continuing Easterly along the aforesaid line extended a distance of 166.27 feet, thence Southerly by a deflection angle $96^{\circ}36'32''$ to the right a distance of 229.67 feet, thence Westerly by a deflection angle of $95^{\circ}46'08''$ to the right a distance of 165.99 feet, thence Northerly by a deflection angle of $84^{\circ}13'52''$ to the right a distance of 193.84 feet to the point of beginning, St. Paul, Minn.

Contains 34,973 Sq. Ft., more or less.

