

FROM THE OFFICE OF

CHARLES O. GEORGI COMPANY

2215 West County Road B

Saint Paul, Minnesota 55113

REGISTERED CIVIL ENGINEER AND LAND SURVEYOR

Certificate of Survey

I Hereby Certify that this plat shows a survey made by me of the property described on this plat, and that the corners are correctly placed as shown, and that all locations have been correctly shown.

Surveyed For Port Authority

Date October 1966

Scale 1" = 100'


By Charles O. Georgi
REGISTERED LAND SURVEYOR

Description:

All that part of Lots 1, 2, 3, 4, 7, 8, 15 and 16, Block 9, Marshall's Addition to West St. Paul lying within the following described parcel of land:

Commencing at the intersection of the centerlines of Fillmore Ave and old Robert St. as dedicated by the plat of Bazille and Roberts Addition to West St. Paul, thence Northeasterly along the centerline of Fillmore Ave a distance of 410 feet, thence Southeasterly along a line parallel to said Robert St. a distance of 70 feet to the point of beginning of the parcel of land herein described, thence continuing along aforesaid line extended a distance of 150 feet, thence Northeasterly along a line parallel to said Fillmore Ave. a distance of 100 feet thence Northwesterly along a line parallel to said Robert Street a distance of 150 feet, thence Southwesterly along the Southeasterly line of Fillmore Ave. as widened 40 feet from above said plats a distance of 100 feet to the point of beginning. Subject to a utility easement over the Southeasterly 7.5 feet thereof.

Contains: 15,000 Sq. Ft., more or less.

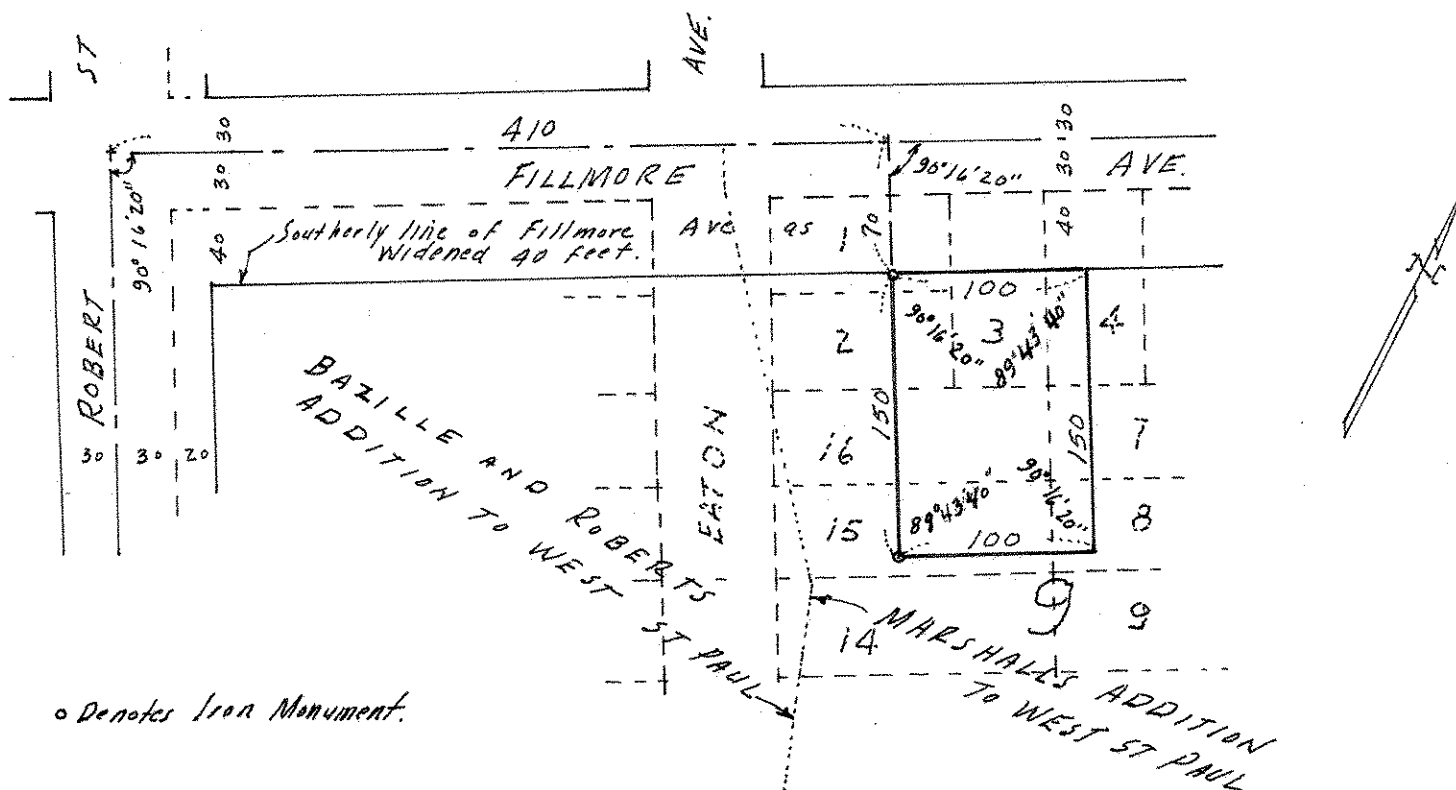

o Denotes Iron Monument.