

FROM THE OFFICE OF

CHARLES O. GEORGI COMPANY

2215 West County Road B

Saint Paul, Minnesota 55113

REGISTERED CIVIL ENGINEER AND LAND SURVEYOR

**Certificate
of Survey**


I Hereby Certify that this plat shows a survey made by me of the property described on this plat, and that the corners are correctly placed as shown, and that all locations have been correctly shown.

Surveyed For *The Knutson Company*Date *March* 1973Scale *1" = 100'*By *Charles O. Georgi*
REGISTERED LAND SURVEYOR**Description:**

All that part of Lot 3, Block 1, Park Homes, Ramsey County, Minn. lying Northerly of the below described line:

beginning at a point on the West line of said Lot 3 distant 223 feet South (assumed bearing) of the Northwestern corner of said Lot 3, thence East 130 feet, thence North 20 feet, thence N 78° 22' E 148.04 feet to a point on the East line of said Lot 3 distant 173.15 feet South of the Northeast corner of said Lot 3 and there terminating.

Subject to Easements of record.

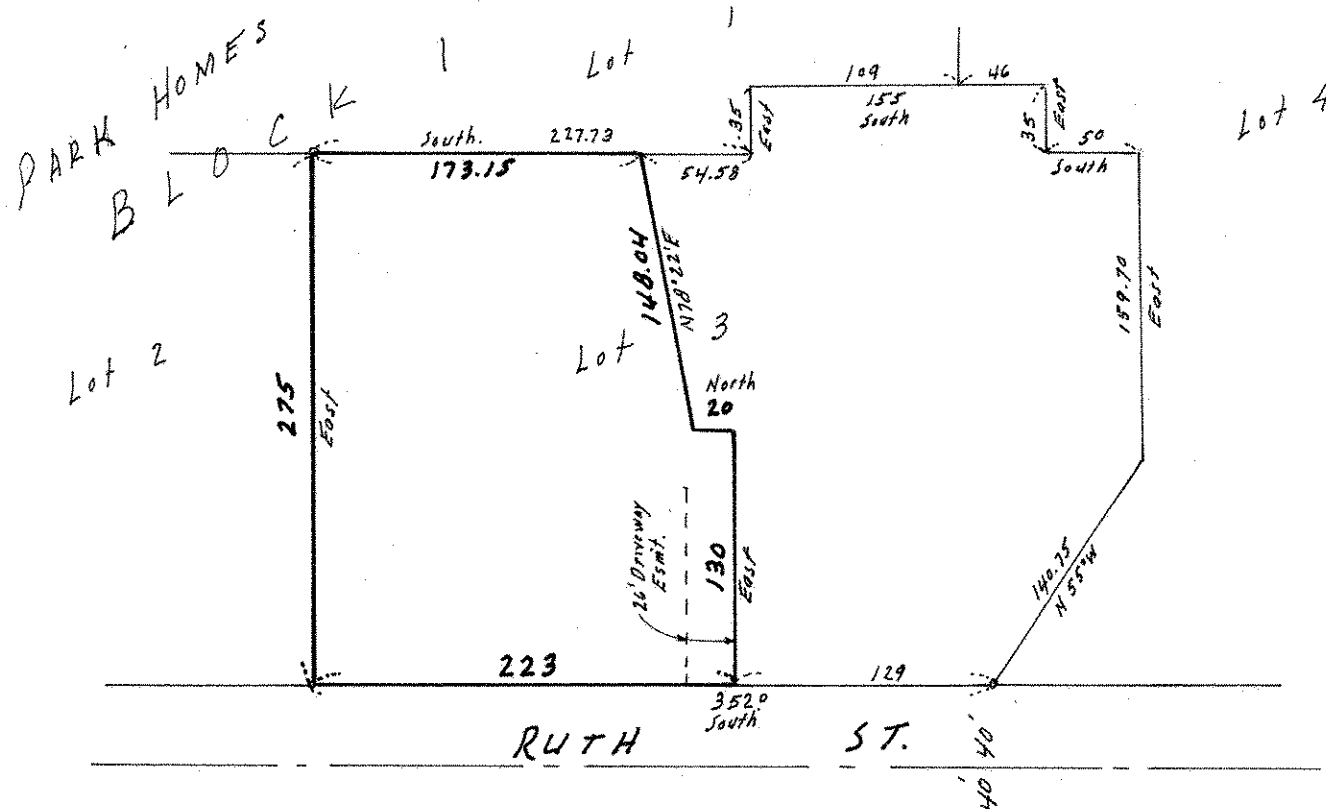

o Denotes Iron Monument.