

FROM THE OFFICE OF

CHARLES O. GEORGI COMPANY

2215 West County Road B

Saint Paul 13, Minnesota

REGISTERED CIVIL ENGINEER AND LAND SURVEYOR

**Certificate
of Survey**

I Hereby Certify that this plat shows a survey made by me of the property described on this plat, and that the corners are correctly placed as shown, and that all locations have been correctly shown.

Surveyed For Muske Tansey Realty Co.

Date Oct. 1962

Scale 1" = 50'

By Charles O. Georgi
REGISTERED LAND SURVEYOR


Description: (OWN)

Lot 16, Block 6, Marshall's Addition to West St. Paul.

The South 0.2 feet of Lots 5 and 6 and of the West 1.35 feet of Lot 9, also the West 1.35 feet of Lots 10, 11 and 12 and all of Lots 13 and 14, Block 6, Marshall's Addition to West St. Paul.

(LEASE)

Except the West 1.35 feet, all of Lots 10, 11 and 12, Block 6, Marshall's Addition to West St. Paul.

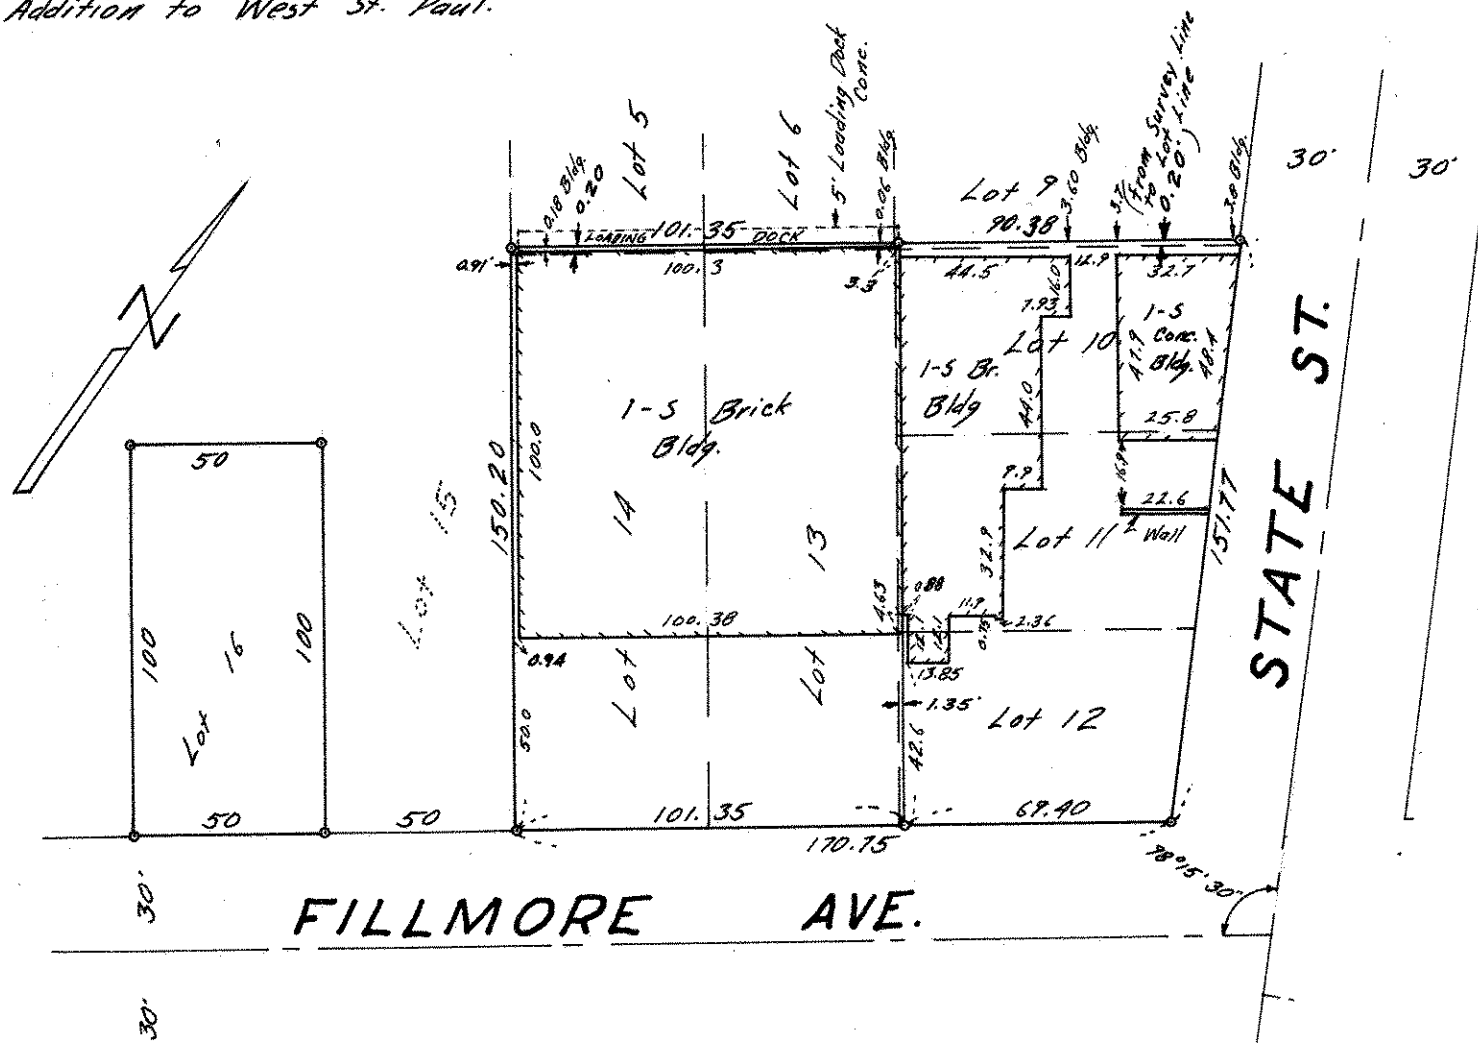

° Denotes Iron Monument