

FROM THE OFFICE OF

CHARLES O. GEORGI COMPANY

2215 West County Road B

Saint Paul, Minnesota 55113

REGISTERED CIVIL ENGINEER AND LAND SURVEYOR

**Certificate
of Survey**

I Hereby Certify that this plat shows a survey made by me of the property described on this plat, and that the corners are correctly placed as shown, and that all locations have been correctly shown.

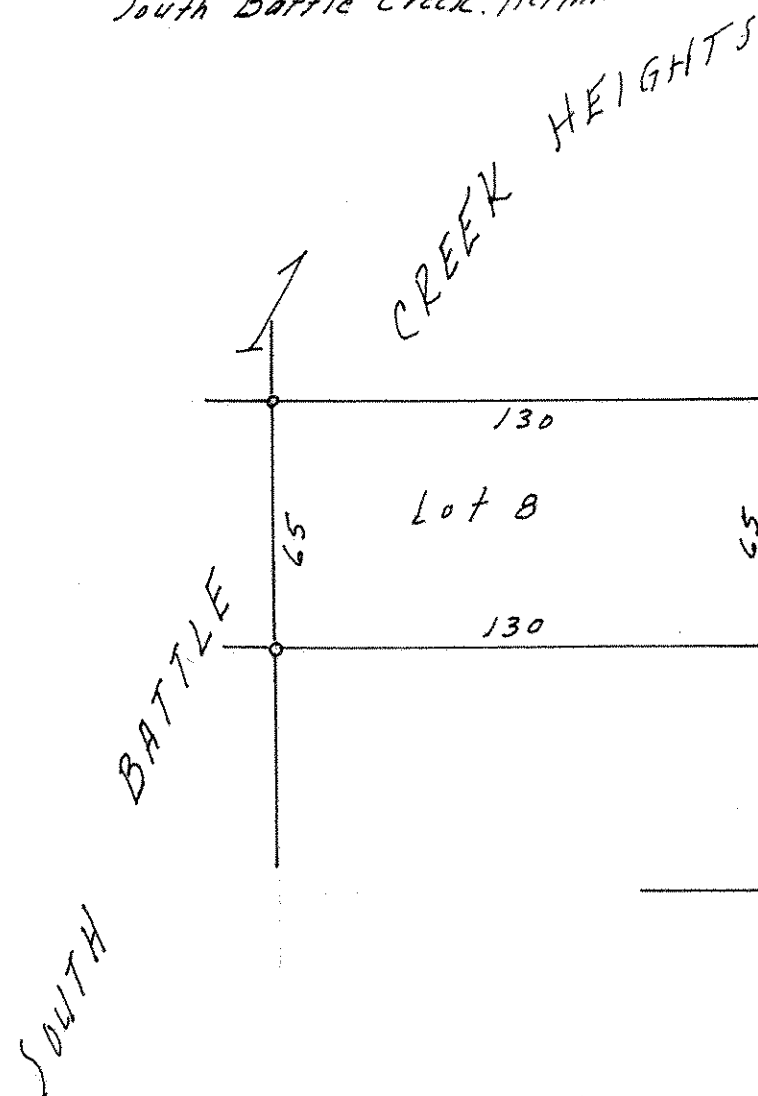
Surveyed For *JOHN MARSHALL*

Date *May 1966*

Scale *1" = 50'*

By

Charles O. Georgi
REGISTERED LAND SURVEYOR

Description:*Lot 8**Block 1**South Battle Creek Heights*

o Denotes Iron Monument.