

NE 14 28 22

Certificate of Survey

From the office of
GEORGI-SCHMIDT & ASSOC. INC.
3092 No. Lexington Ave., Roseville, Mn. 55113
LAND SURVEYING
483-4408

I Hereby Certify that this plat shows a survey made by me of the property described on this plat, and that the corners are correctly placed as shown, and that all locations have been correctly shown.

Job Number: 641

Surveyed For SOMMER CONST.


Date MAY 1980

Scale 1" = 40

By Donald W. Schmidt
REGISTERED LAND SURVEYOR

Description:

Lots 25 & 26, Block 2
HIGHWOOD HILLS
RANSEY COUNTY, MINN.

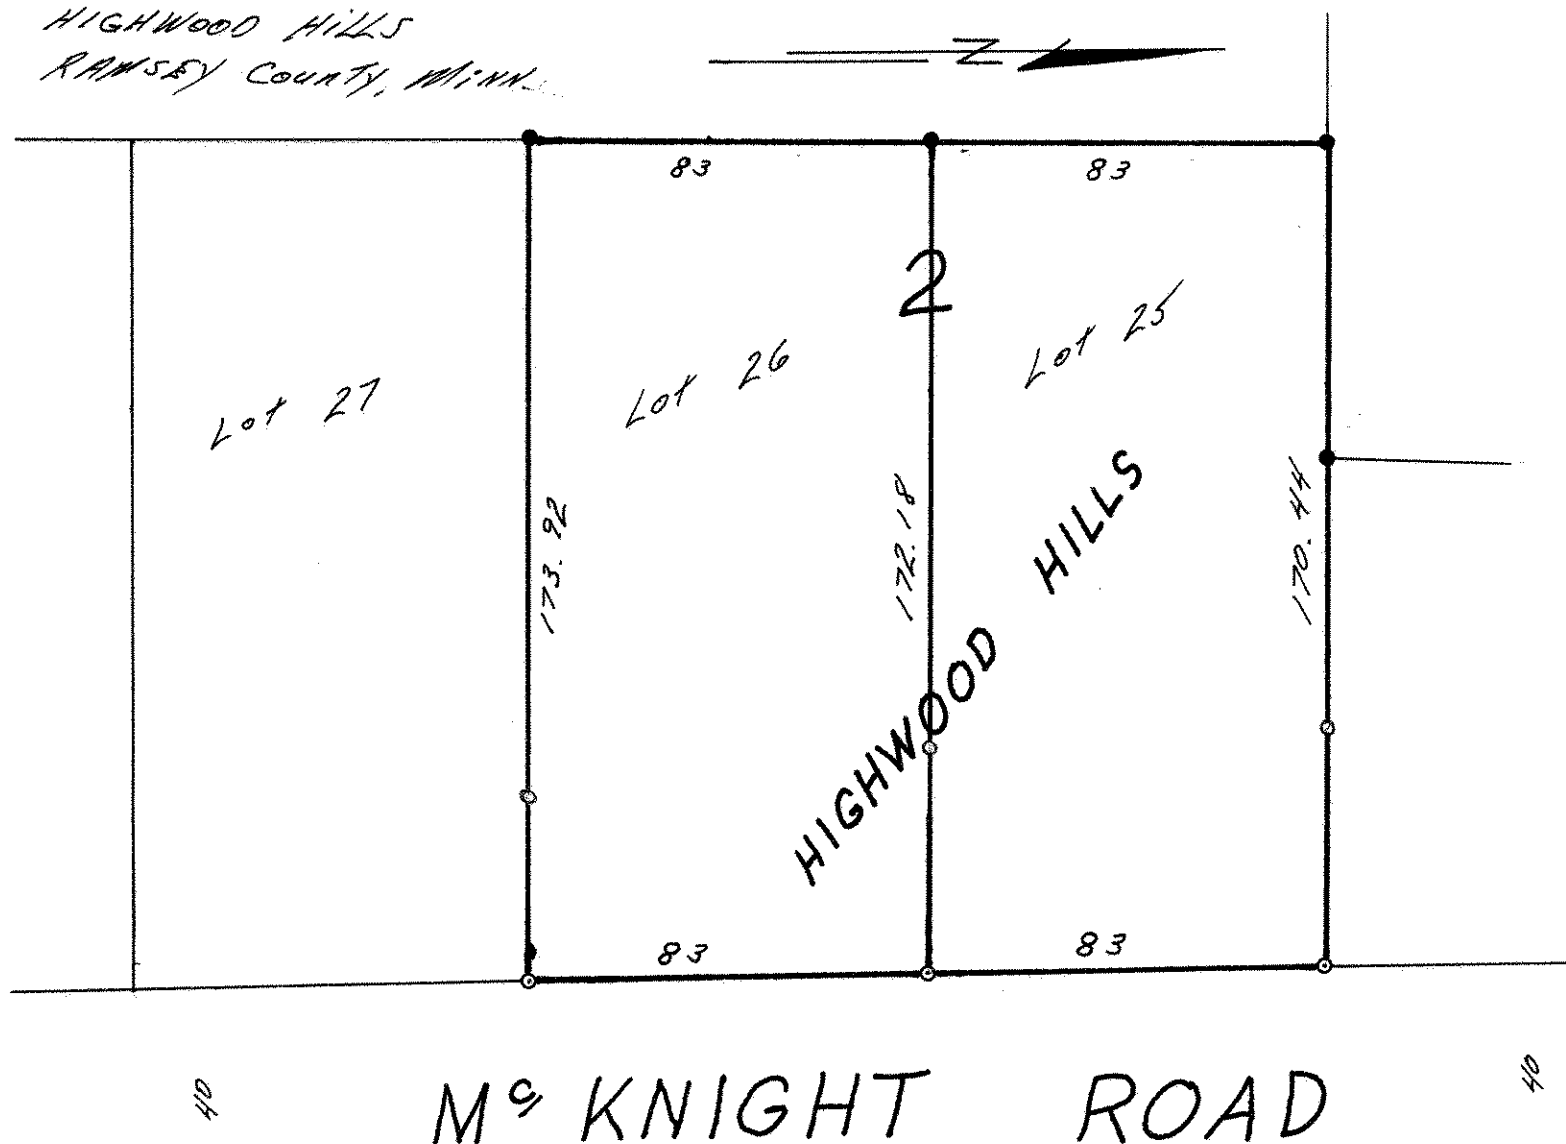

- denotes iron pipe monument found
- denotes iron pipe monument set