SE112822

FROM THE OFFICE OF

CHARLES O. GEORGI COMPANY

2215 West County Road B Saint Paul, Minnesota 55113

REGISTERED CIVIL ENGINEER AND LAND SURVEYOR

Certificate of Survey

I Hereby Certify that **this plat shows a survey made by me of the property described on this plat, and that the corners are correctly placed as shown, and that all locations have been correctly shown.**

5/5/75 Placed Irons & Added all Dimensions

Surveyed For R. Theis

Date October 30, 1974

Scale 1" = 50'

By Charles O. Georgi
REGISTERED LAND SURVEYOR

Description:
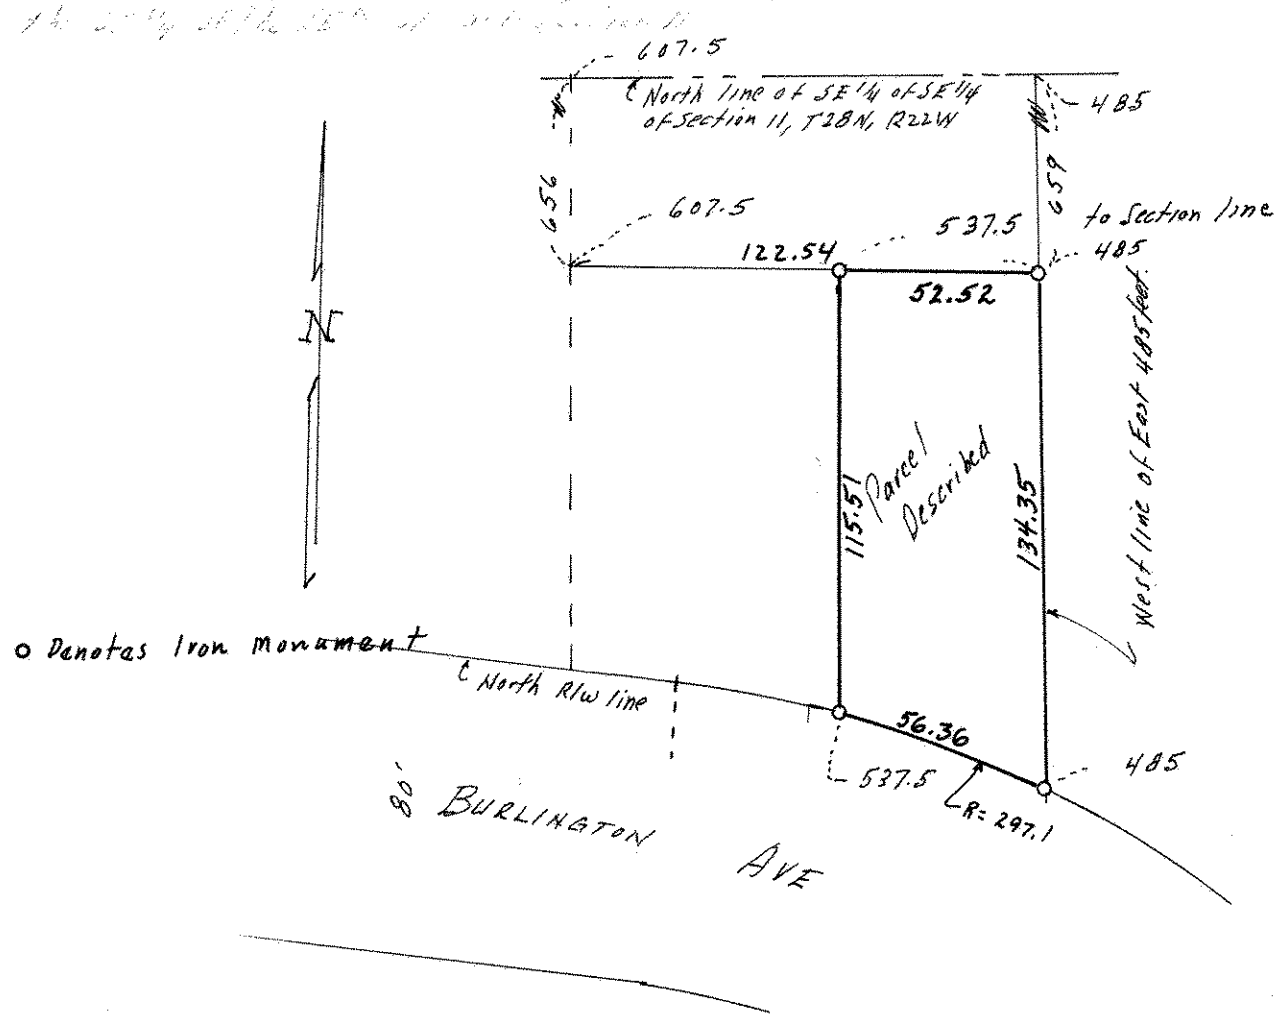
All that part of the West 52.5 feet of the East 537.5 feet of the SE¼ of the SE¼ of Section 11, T28N, R22W, Ramsey County, Minn. lying Northerly of the North line of Burlington Ave. as shown on the plat of Burlington Heights, Division No 2, and lying Southerly of the following described line: beginning at a point on the West line of the East 485 feet of the SE¼ of the SE¼ of said Section 11, distant 659 feet South of the North line thereof, thence Northwesterly 122.6 feet, more or less, to a point on the West line of the East 607.5 feet of the SE¼ of the SE¼ of said Section 11, distant 656 feet South of the North line thereof and there terminating.