SE 14 28 22

FROM THE OFFICE OF

CHARLES O. GEORGI COMPANY

2215 West County Road B Saint Paul, Minnesota 55113

REGISTERED CIVIL ENGINEER AND LAND SURVEYOR

Certificate of Survey

I Hereby Certify that **this plat shows a survey made by me of the property described on this plat, and that the corners are correctly placed as shown, and that all locations have been correctly shown.** 3/11/75 Added Road Doc. No.

Surveyed For Scott Nelson

Date March 1975

Scale 1" = 60'

By Charles O. Georgi
REGISTERED LAND SURVEYOR

Description:

The West 283.1 feet of the East 606.0 feet of all that part of the NE 1/4 of the SE 1/4 of Section 14, T28, R22 lying Southerly of Registered Land Survey No. 47, except the South 163.54 feet thereof, together with a road easement by Document No. 458557.
Contains 1.066 acres, more or less.

Ramsey County, Minnesota

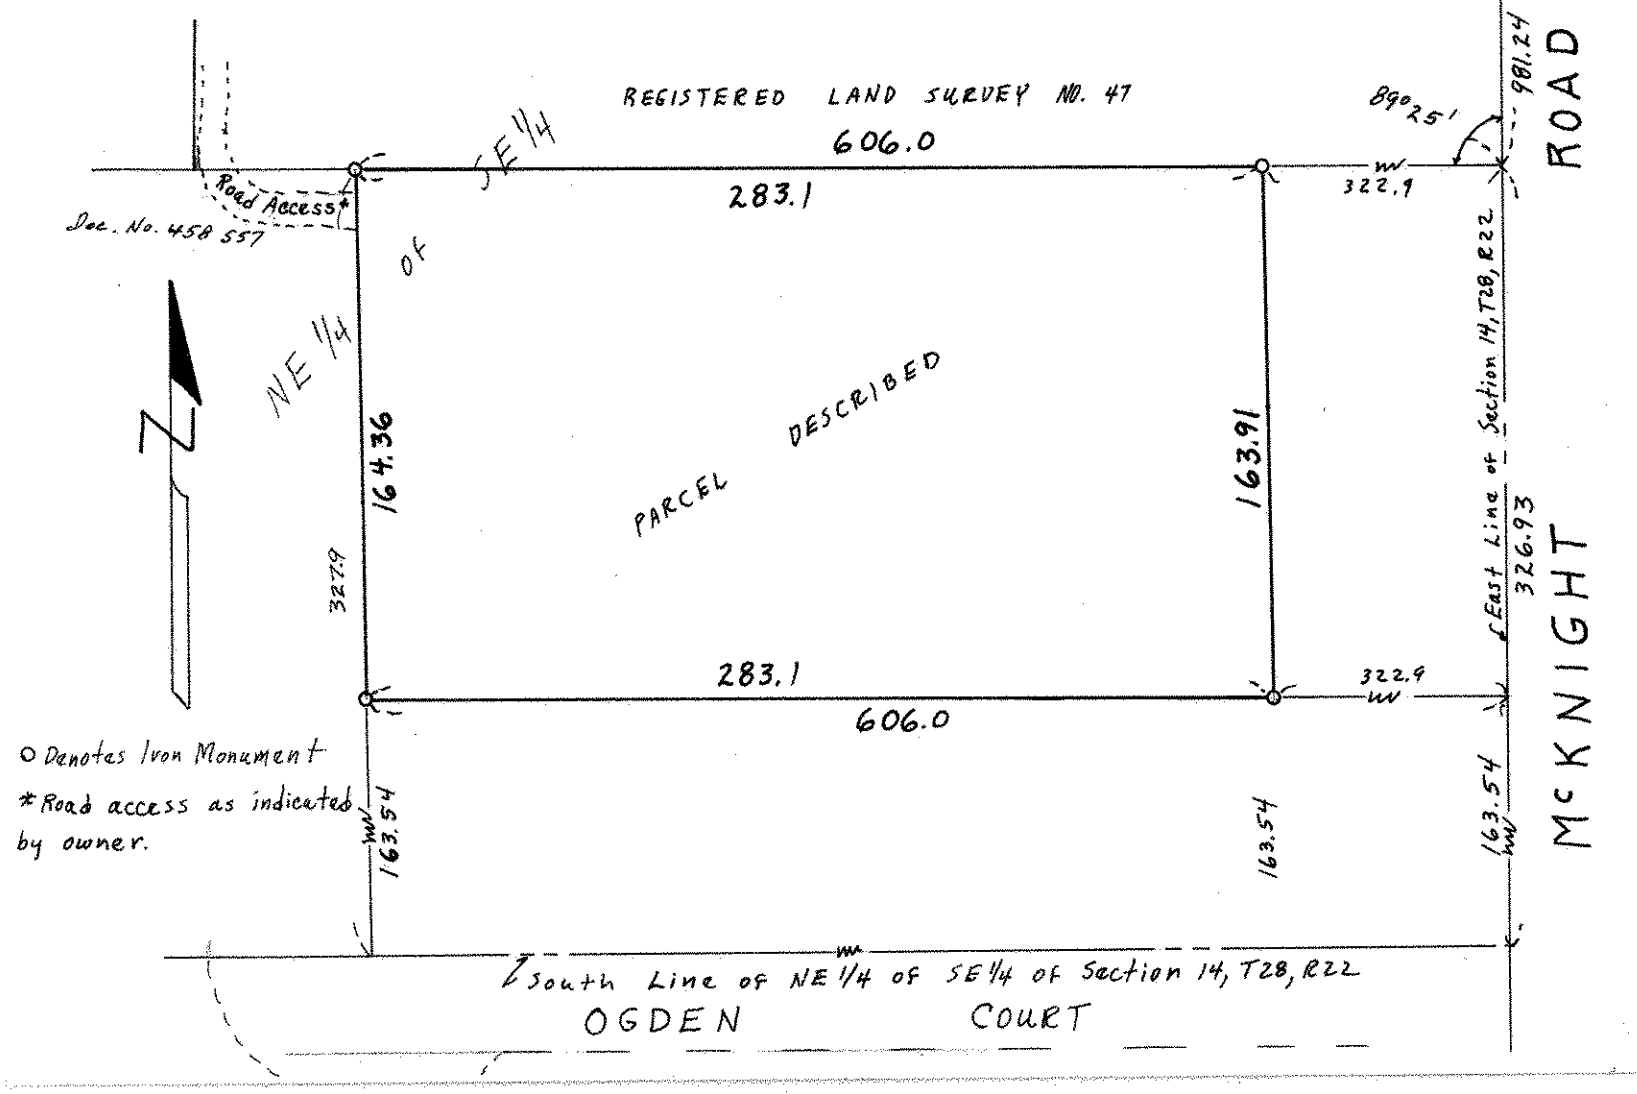

O Denotes Iron Monument

*Road access as indicated by owner.