

SE 14, 28, 22

FROM THE OFFICE OF

CHARLES O. GEORGI COMPANY

2215 West County Road B

Saint Paul 13, Minnesota

REGISTERED CIVIL ENGINEER AND LAND SURVEYOR

Certificate of Survey

I Hereby Certify that this plat shows a survey made by me of the property described on this plat, and that the corners are correctly placed as shown, and that all locations have been correctly shown.

Surveyed For *Clinton & Elly M. Oscarson, Jr.*


Date..... *Feb 1964*

Scale..... *1" = 50'*

By..... *Charles O. Georgi*
REGISTERED LAND SURVEYOR

Description:

*The East 134.3 Feet of the North
133.54 Feet of the South 163.54 feet
of the NE $\frac{1}{4}$ of the SE $\frac{1}{4}$ of Section
14, 28, 22, according to U.S. Government
Survey Thereof. Subject to Mc Knight Road.*

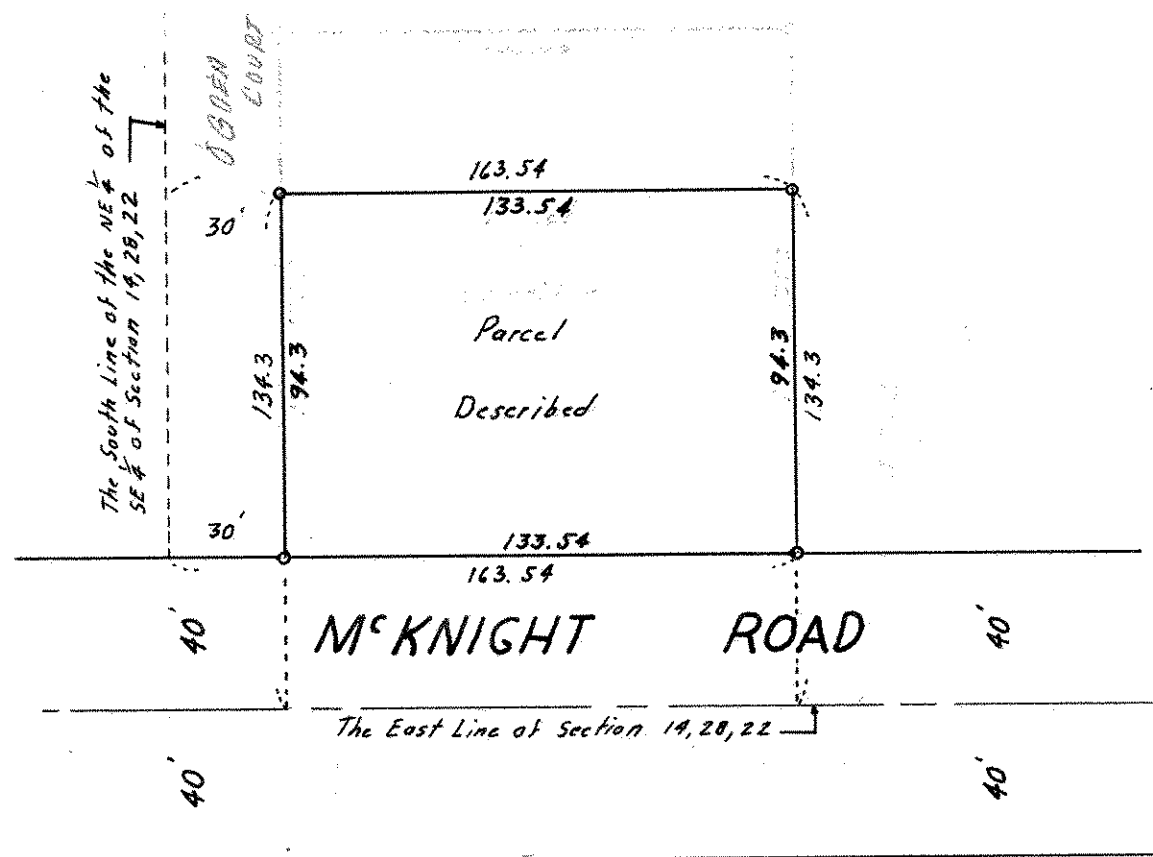

o Denotes Iron Monument