

FROM THE OFFICE OF

CHARLES O. GEORGI COMPANY

2215 West County Road B

Saint Paul, Minnesota 55113


REGISTERED CIVIL ENGINEER AND LAND SURVEYOR

**Certificate
of Survey**

I Hereby Certify that this plat shows a survey made by me of the property described on this plat, and that the corners are correctly placed as shown, and that all locations have been correctly shown.

Surveyed For *Steve Aman*Date *July 1973*Scale *1"=60'*By *Charles O. Georgi*
REGISTERED LAND SURVEYOR**Description:**

*Lots land 2, Block 4, Lewiston Heights
Second Addition, Ramsey County,
Minnesota.*

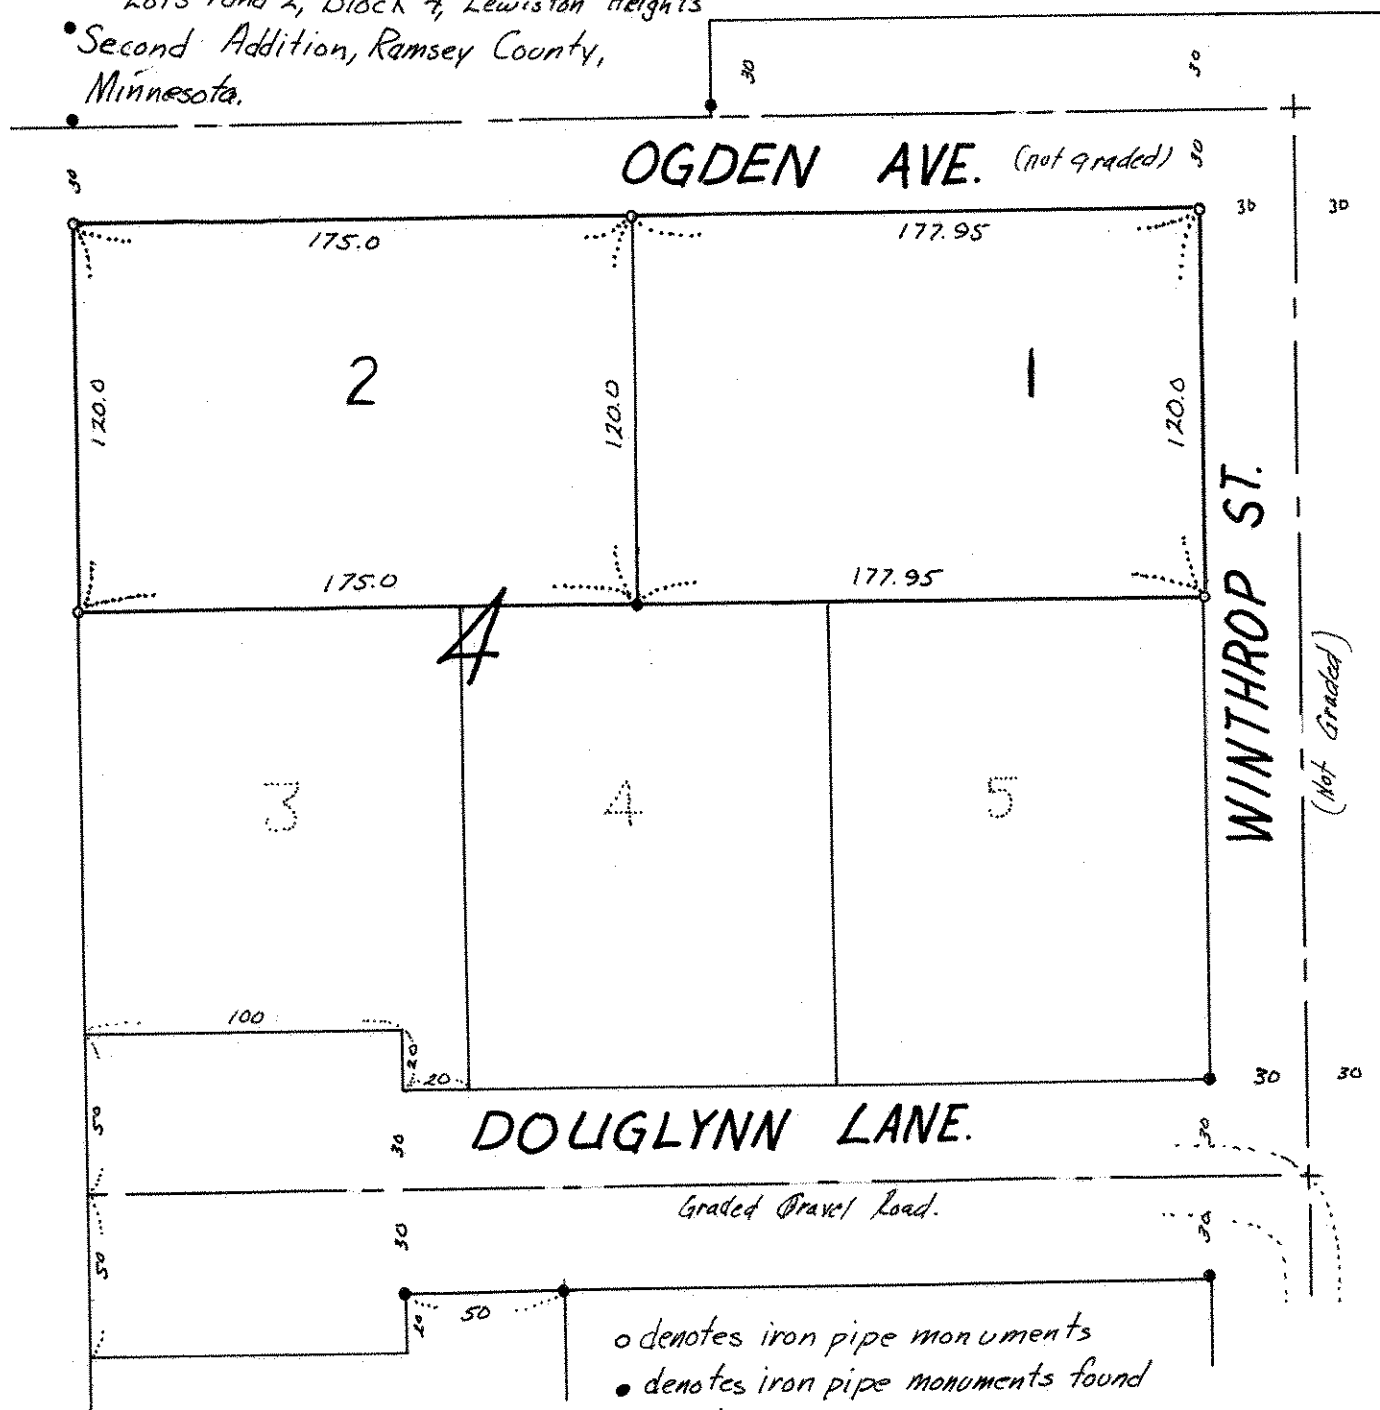

Survey in accord with plat of record.