

PLAT OF SURVEY

Y OF Warren - Dodge


FOLLOWS Lot 14, Blk 18, Auditors Subdivision No. 11

13 Portland Ave. - St. Paul, Minn.

NCH 30 FEET.

T. J. WELCH, REGISTERED SURVEYOR
738 VAN BUREN PLACE, ST. PAUL, MINN.

NORTH ↑

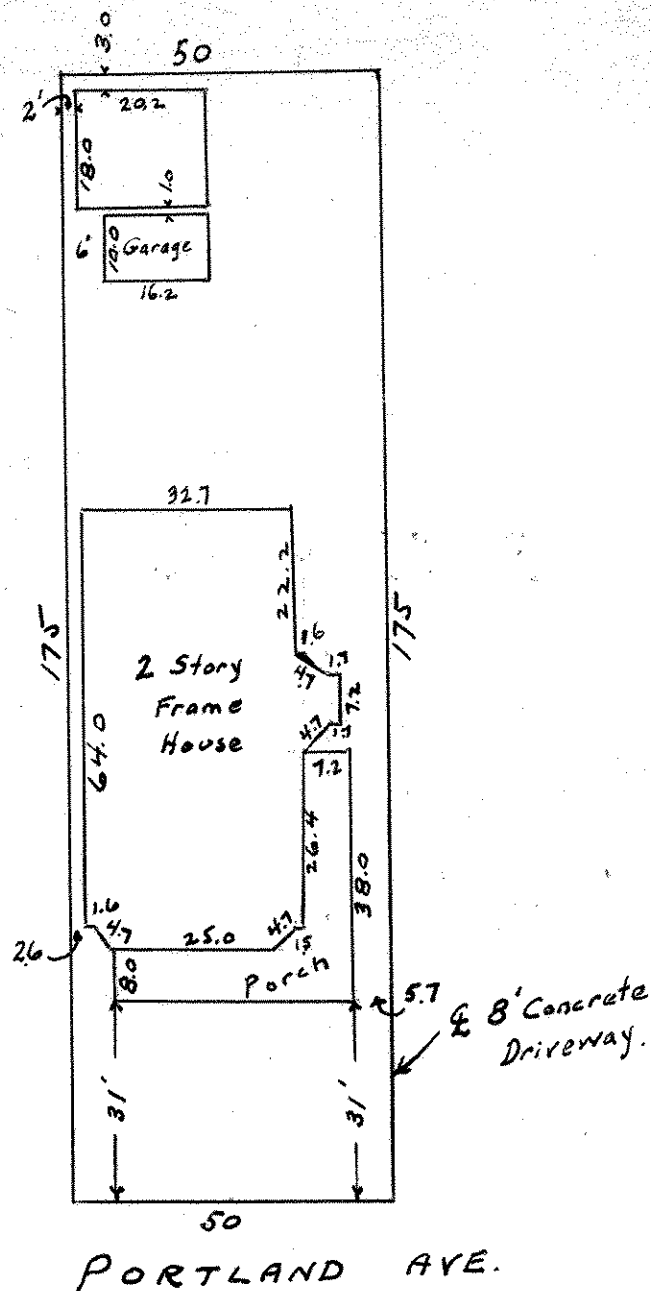

CERTIFICATE OF LOCATION OF BUILDING

I hereby certify that on Apr 4, 1939
I made a survey of the location of the building on the above
described property and that the location of said building is
correctly shown on the above plat.

T. J. Welch

CERTIFICATE OF SURVEY

I hereby certify that on Apr 4, 1939
I surveyed the property described above and that the above
plat is a correct representation of said survey.

T. J. Welch