

APPL. #7103


TELEPHONE 776-0640

PLAT OF SURVEY

OF PROPERTY OF ROBERT D. DAILY
The North 60' of the South 218' of Lot 2 except the West 73 5-10'
DESCRIBED AS FOLLOWS thereof, and the North 60' of the South 218' of Lot 1, Block 61,
Brown and Jackson's Addition to West St. Paul According to the plat thereof on file
and of record in the office of the Register of Deeds in and for Ramsey County,
Minnesota subject to an easement for driveway purposes over across and upon the South
5' of the East '00' of the said part of said Lot one.

SCALE: 1 INCH = 50' FEET

T. J. WELCH, REGISTERED SURVEYOR
701 EAST 3RD STREET, ST. PAUL, MINN. 55106

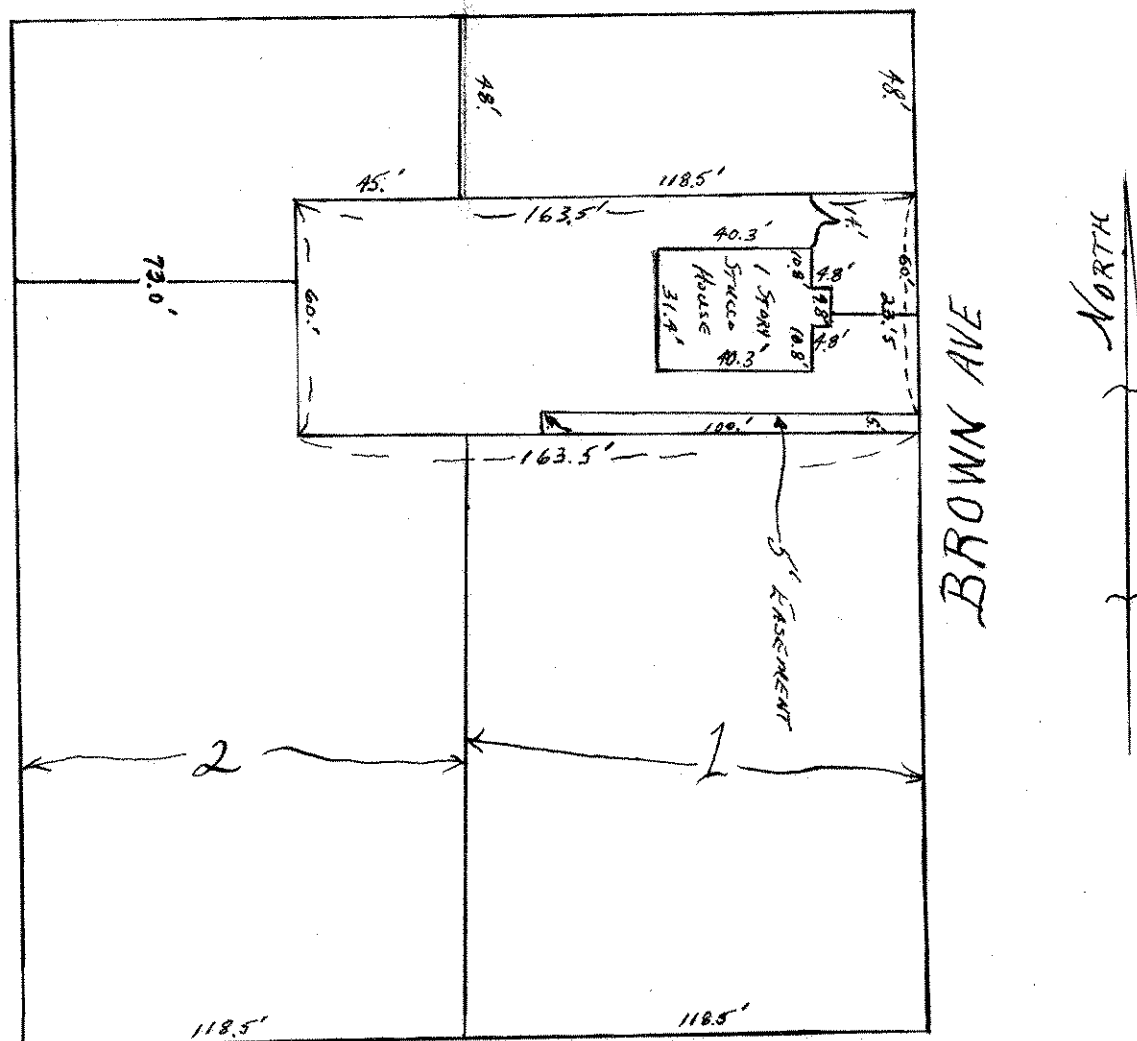

This survey is made exclusively for
First Federal Savings and Loan Assn.
of St. Paul, Minn. Lot lines are not
guaranteed as this is survey for
mortgage purposes only.

CERTIFICATE OF SURVEY

I hereby certify that on Mar. 23, 1974
I surveyed the property described above and that the above
plat is a correct representation of said survey.

T. J. Welch

355/29