


SE 8 28 22

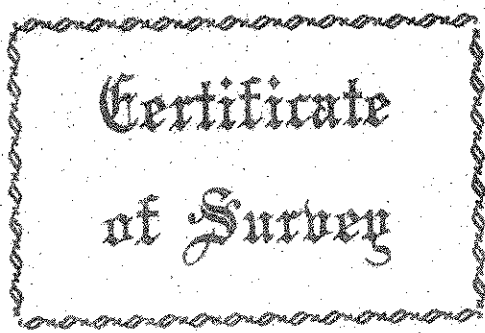

Certificate of Survey

From the office of
GEORGI-SCHMIDT & ASSOC. INC.
3092 No. Lexington Ave., Roseville, Mn. 55113
LAND SURVEYING
483-4408

I Hereby Certify that this plat shows a survey made by me of the property described on this plat, and that the corners are correctly placed as shown, and that all locations have been correctly shown.

Job Number: 354

Surveyed For Hughes Const.


Date May 1979

Scale 1" = 40'

By Gerald W. Schmidt
REGISTERED LAND SURVEYOR

Description:

The South 58 feet, except the West 18.5 Feet thereof,
Lot 1, Block 61, Brown and Jackson's Addition to West St. Paul,
Ramsey County, MN.

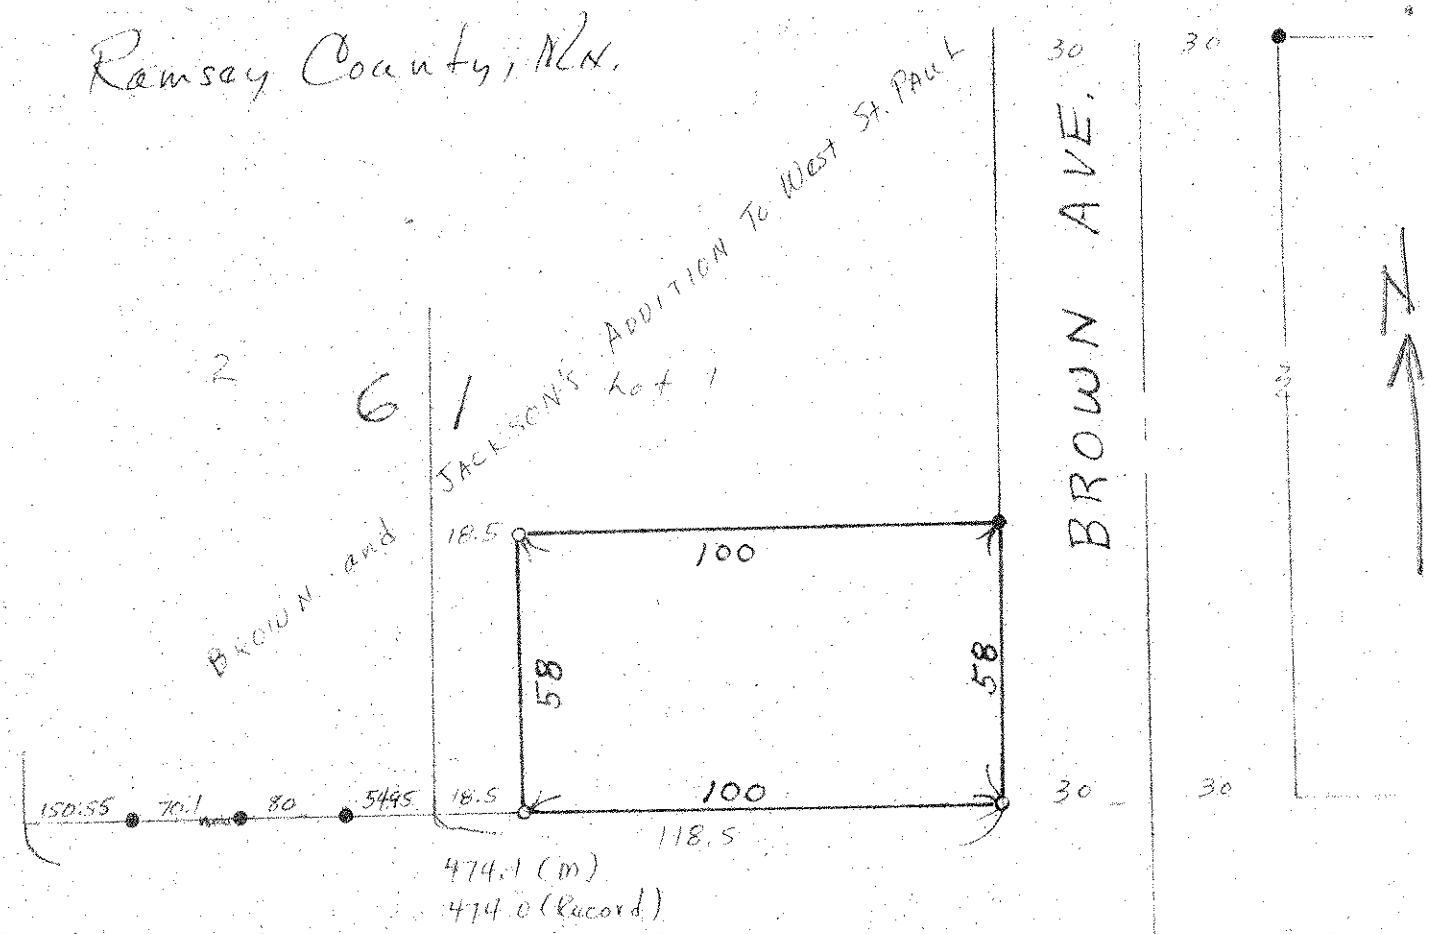

E. WYOMING

○ Denotes Iron Monument
● Denotes Iron Found in place