Appl. № S.H. 3246

TELEPHONE PR 6-0640

PLAT OF SURVEY

OF PROPERTY OF Kallin, Inc.

DESCRIBED AS FOLLOWS The West 21.5 feet of the South 1/2 of Lot 3 and the East 18.5 feet of the South 1/2 of Lot 4, Block 41, Brown and Jackson's Addition to West St. Paul

№ 301 East Page Street, St. Paul, Minn.

SCALE: 1 INCH = 50 FEET

T. J. WELCH, REGISTERED SURVEYOR
738 SURREY AVENUE, ST. PAUL 6, MINN.

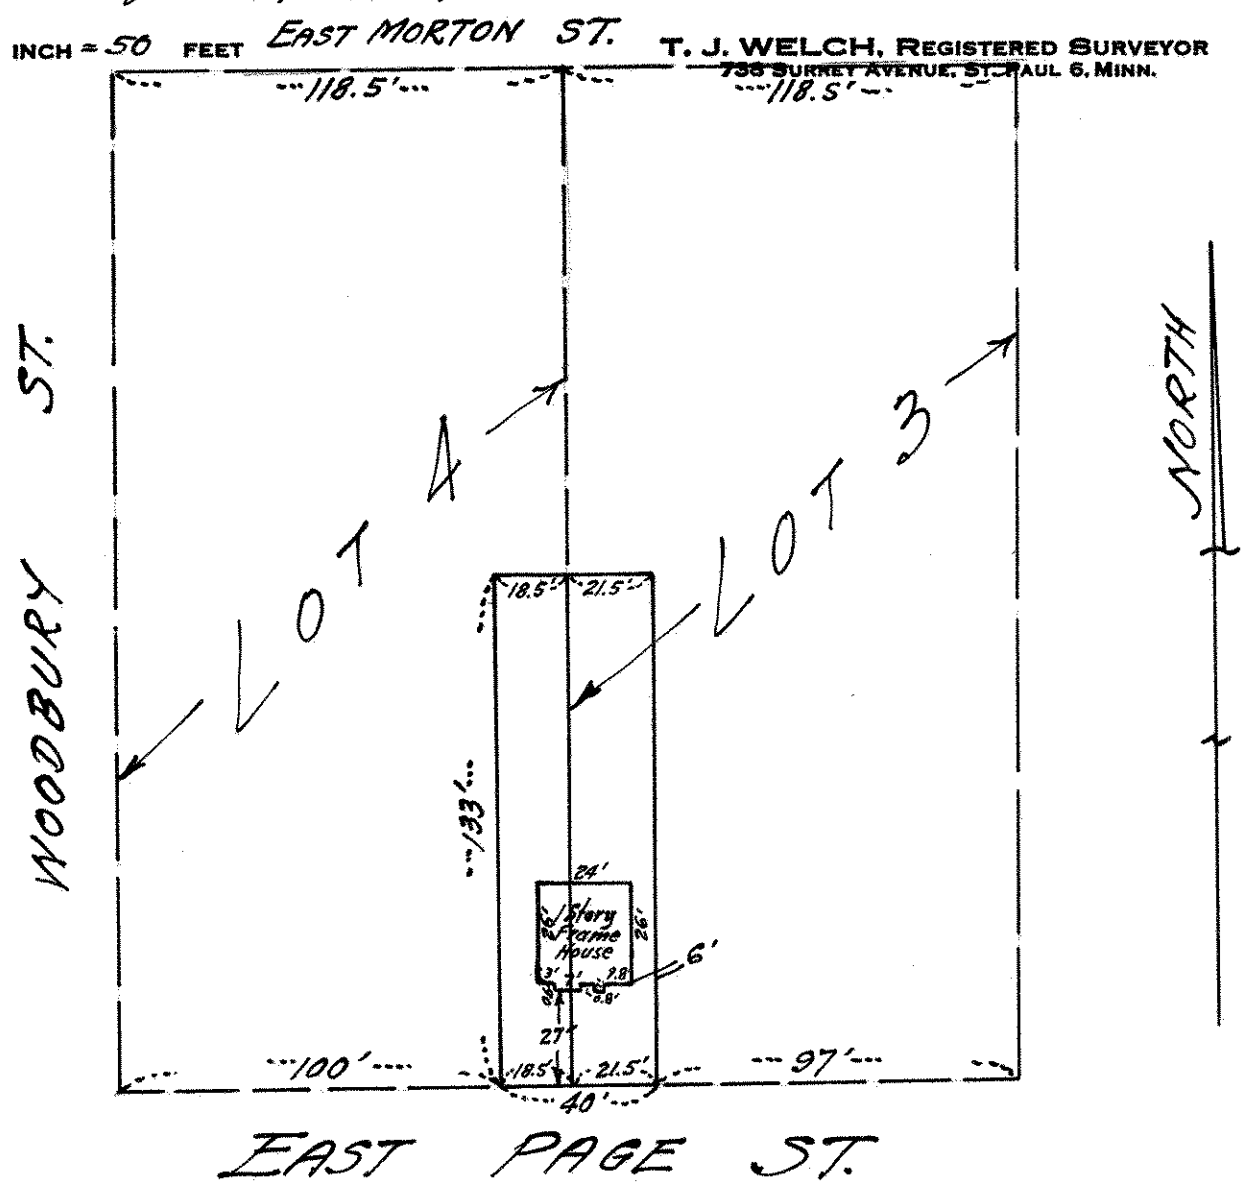

CERTIFICATE OF SURVEY

I hereby certify that on March 22, 1965 I surveyed the property described above and that the above plat is a correct representation of said survey.

T. J. Welch

310/46