

PLAT OF SURVEY


OF PROPERTY OF Roger Ginkel and Jacob Dim

DESCRIBED AS FOLLOWS The North 60' of the South 218' of Lot 1 and the North 60' of the South 218' of Lot 2 except the West 73.5' thereof, Block 61 Brown and Jackson's Addition and subject to easement for driveway purposes over across and upon the South 5' of the East 100' thereof; N^o 829-831 Brown Ave., St. Paul, Minn.

SCALE: 1 INCH = 40 FEET

T. J. WELCH, REGISTERED SURVEYOR
738 SURREY AVENUE, ST. PAUL 6, MINN.

EAST WINONA ST.

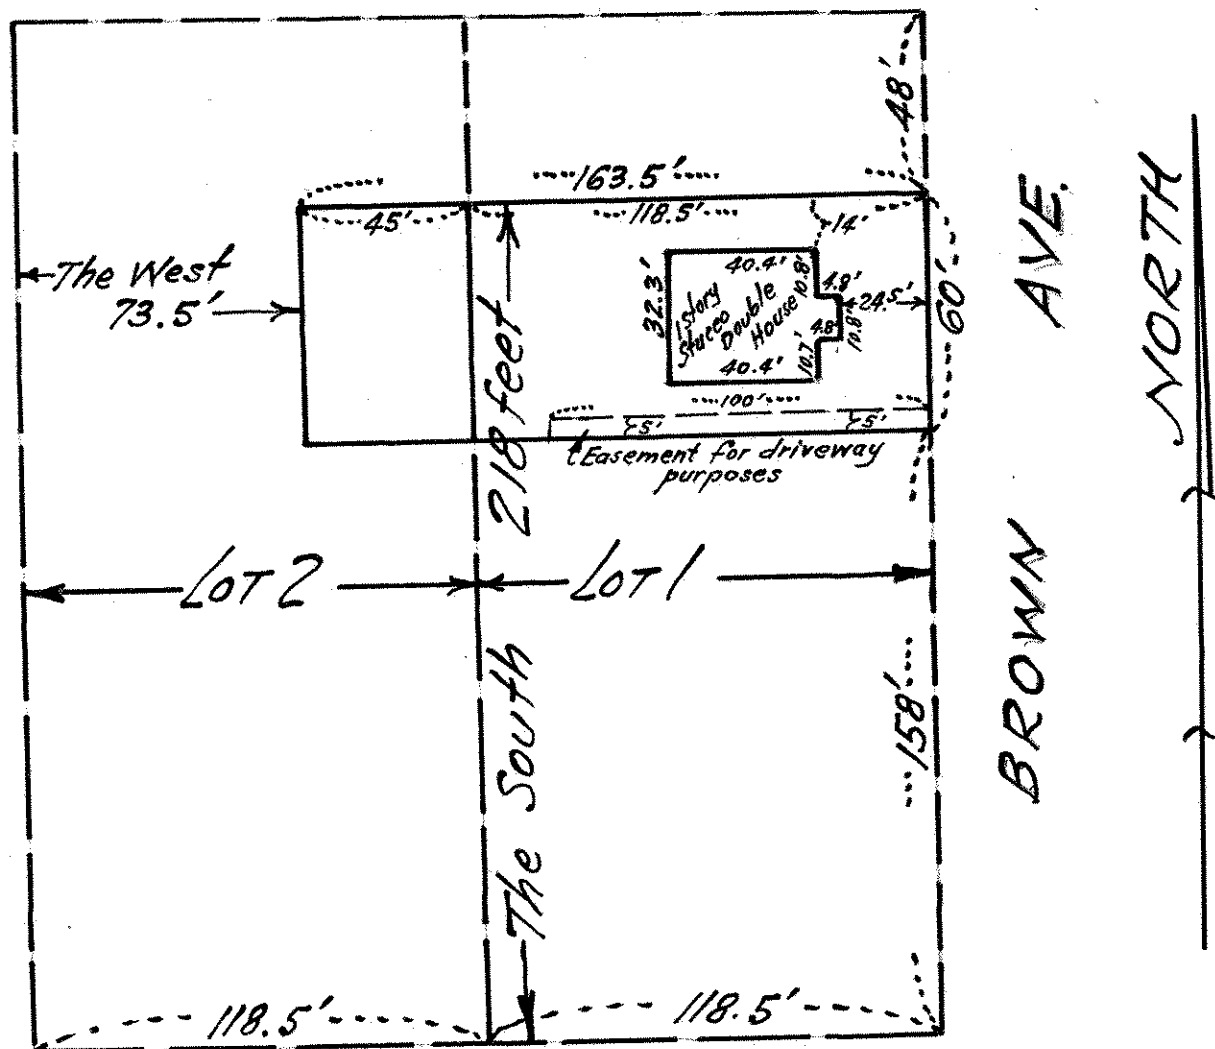

EAST WYOMING ST.

CERTIFICATE OF SURVEY

I hereby certify that on January 2, 1963
I surveyed the property described above and that the above
plat is a correct representation of said survey.

T. J. Welch