

N.W. 1/4 50 1/2 ft of S.W. 1/4 1/2 Lot 2 &
S. ELY 20 ft of S.W. 1/4 1/2 Lot 3

BLOCK 25

BROWN & JACKSON'S ADD.

JOHN B. IRVINE, SURVEYOR.

408 GLOBE BLDG.

ST. PAUL, MINN.


APRIL 24-1915

Scale 20 ft. per inch.

ROBIE ST.

To E. Line - 231.5 -

Bancroft St.

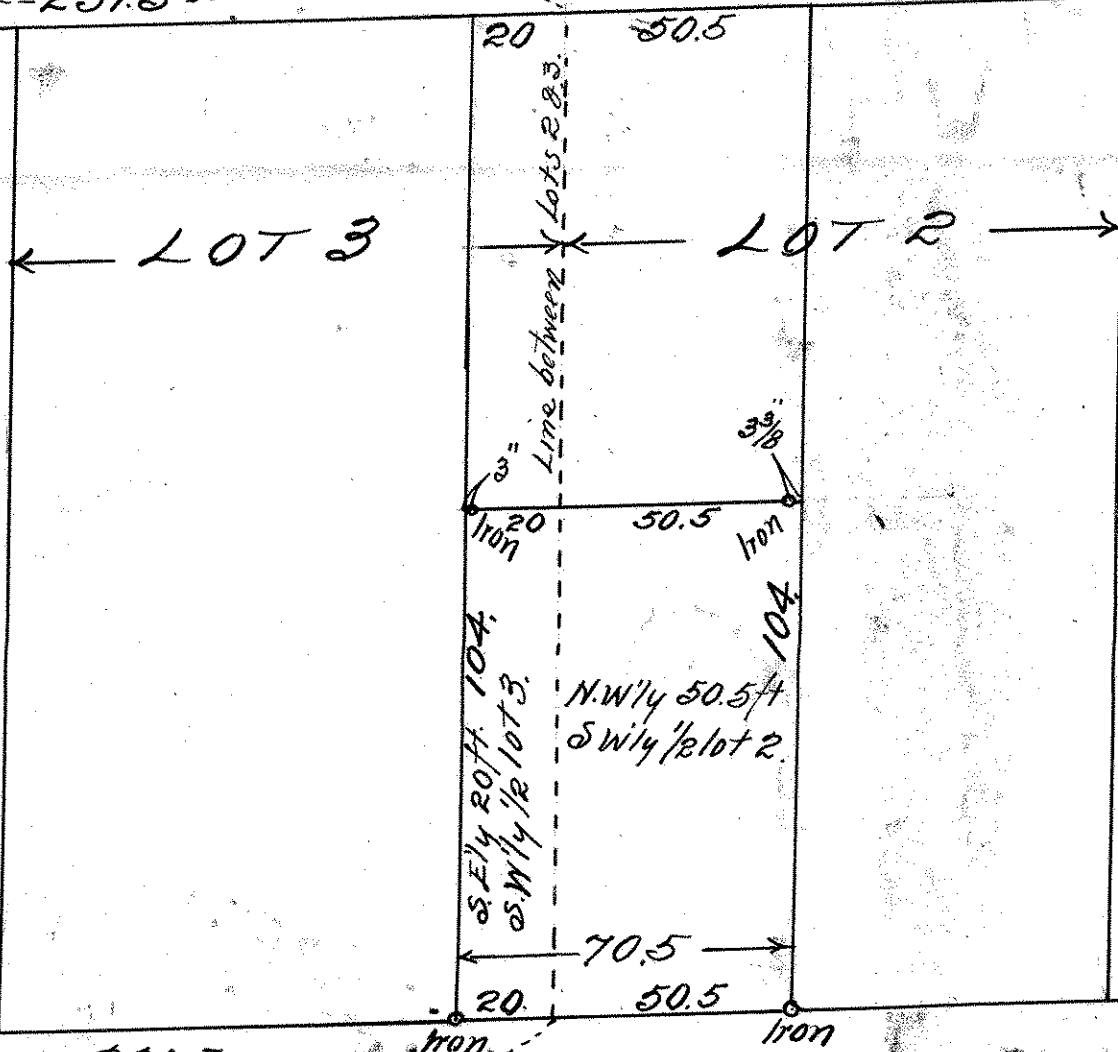

To E. Line - 231.5 -

Bancroft St.

CONCORD ST.