The Westerly 110 ft. of lots 5 & 6 Block 10 Brooklynd Add. lying northerly of a line 97 ft. northerly of and parallel with the southerly line of lot 4 Block 10 Brooklynd Add.
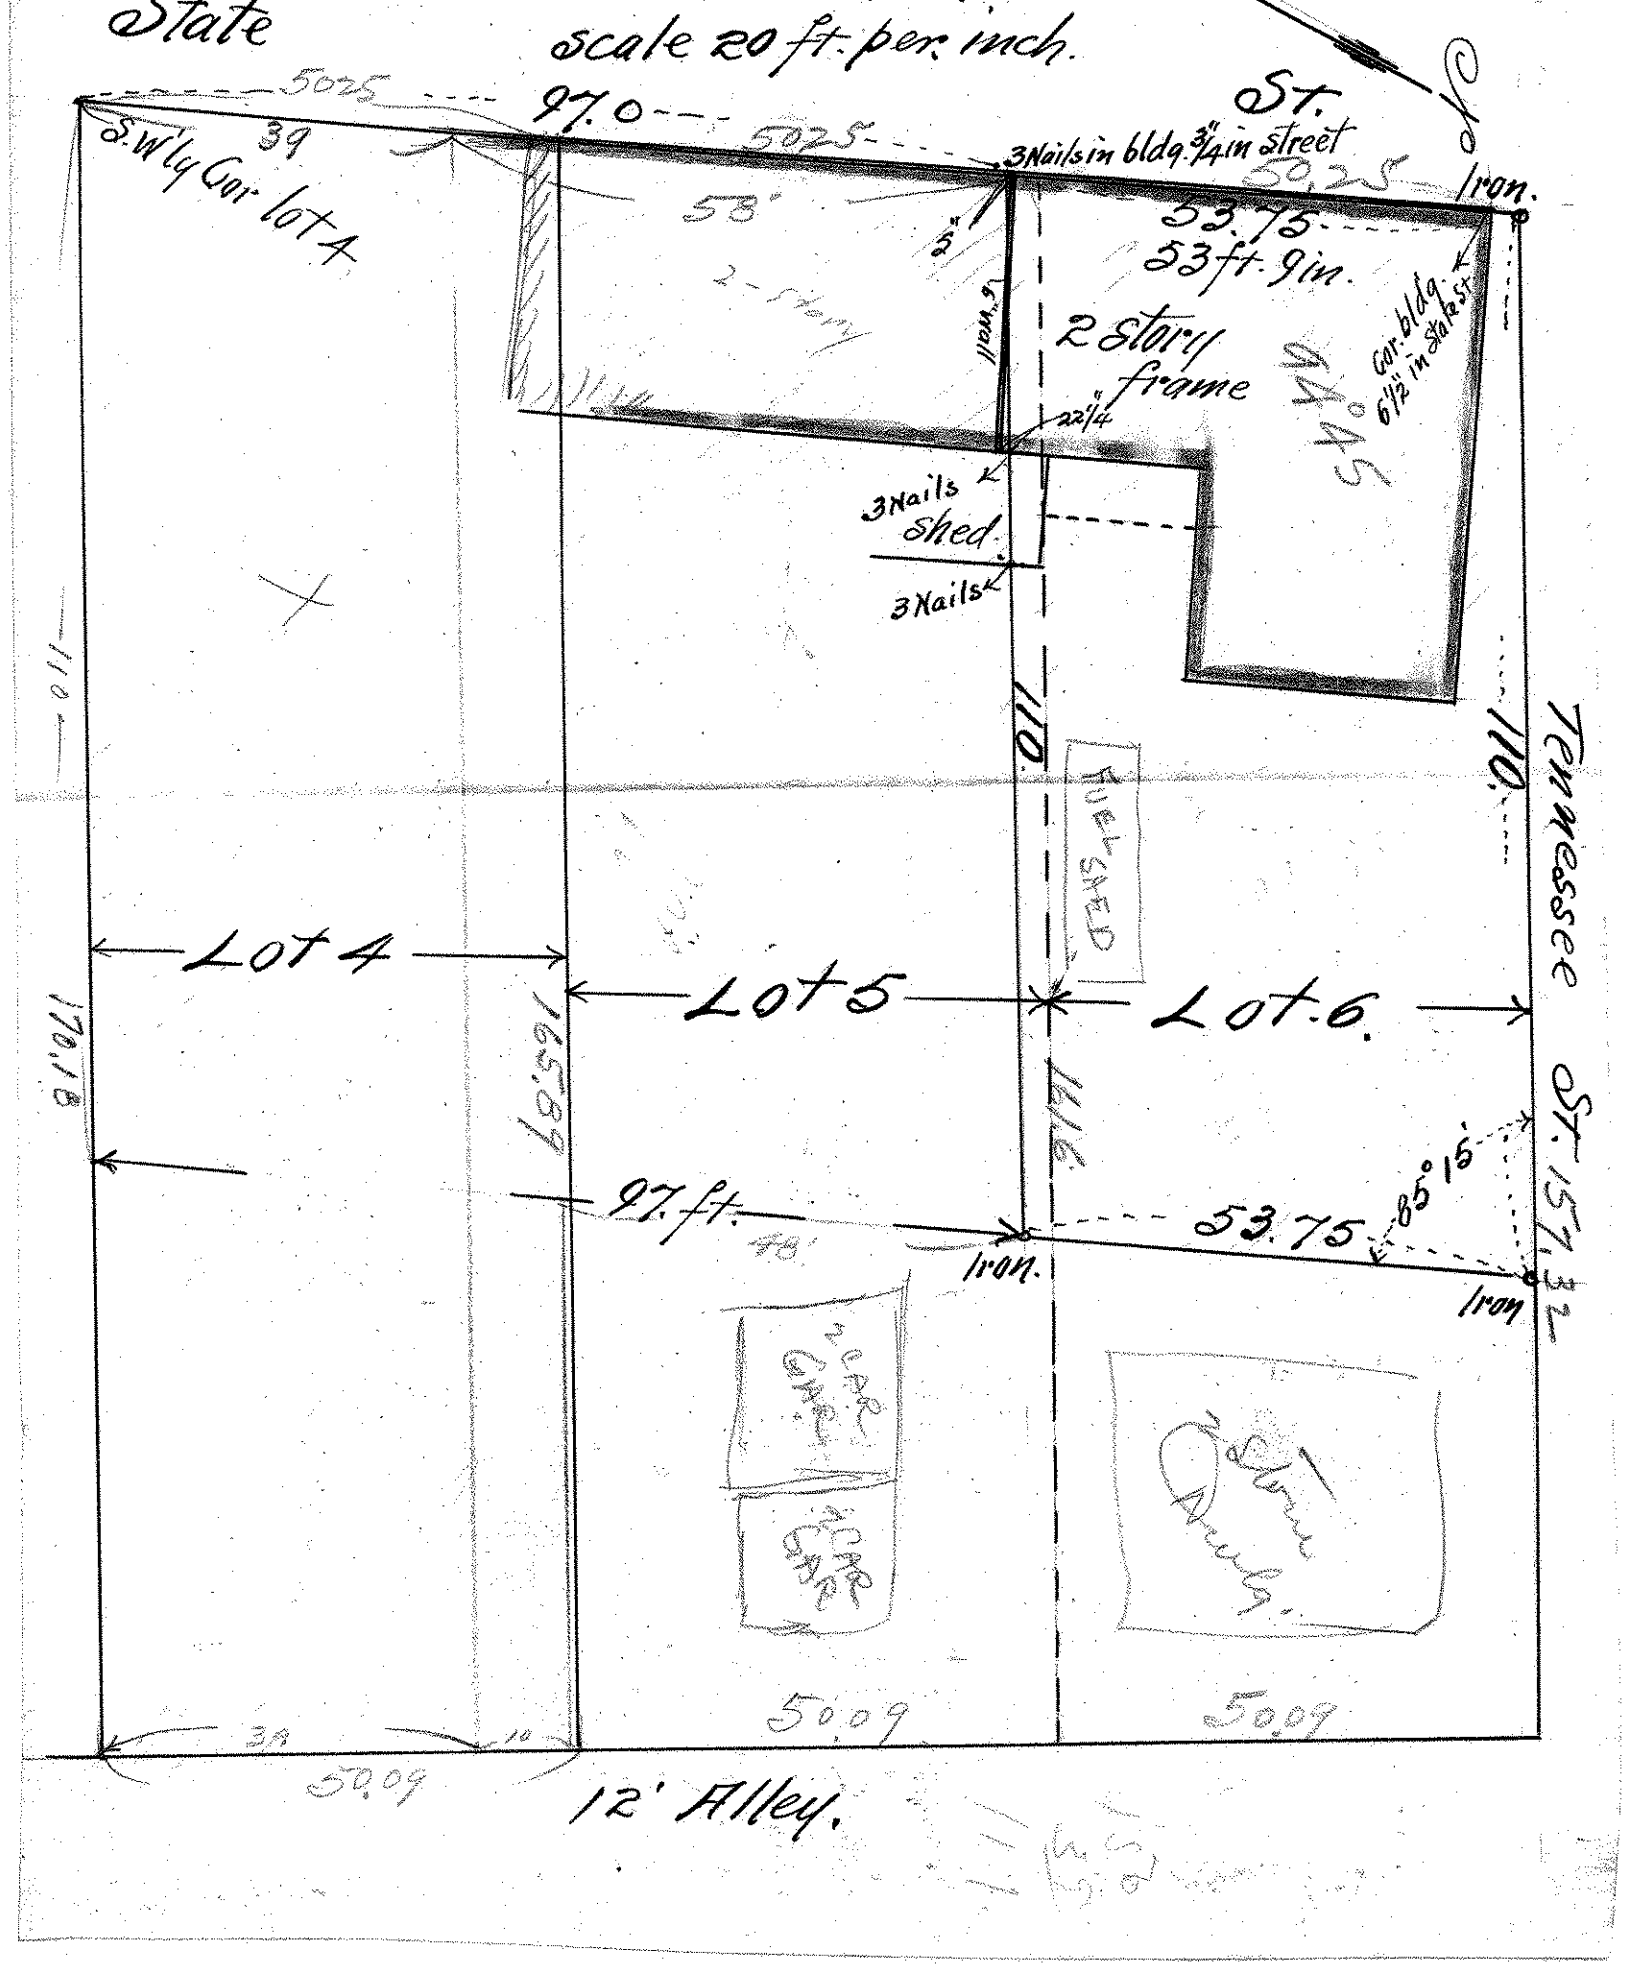
John B. Irvine, Surveyor.
St. Paul, Minn.
Oct. 26-1914.
scale 20 ft. per inch.