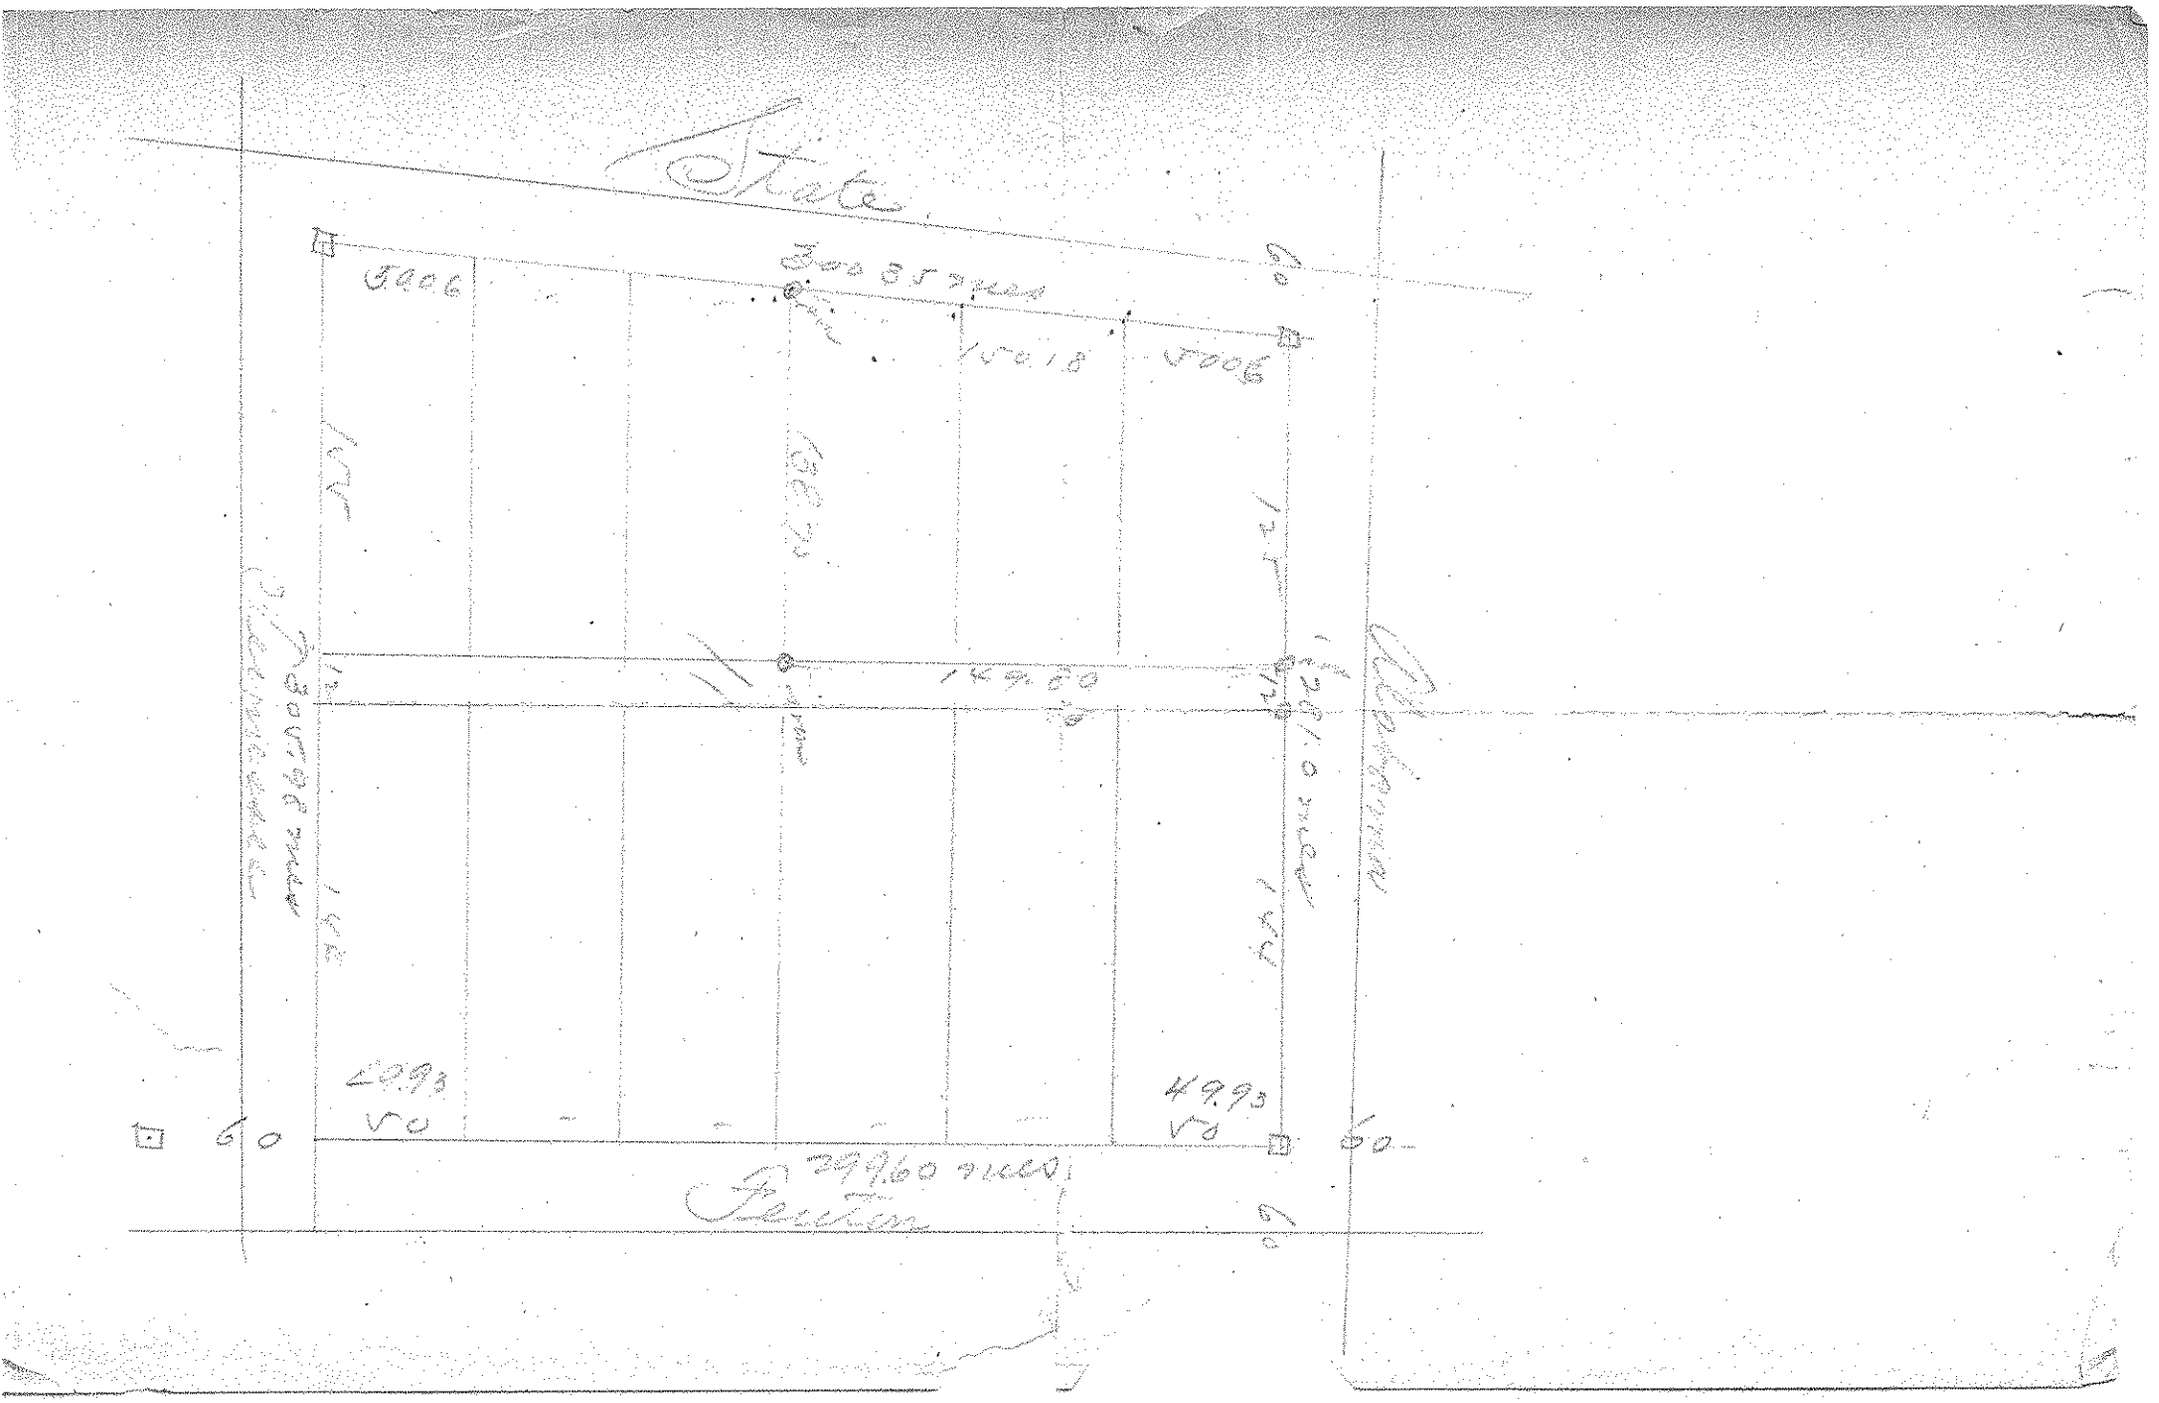
Site
50
50
50
50