

NE 142822

**Certificate
of Survey**

From the office of
GEORGI-SCHMIDT & ASSOC. INC.
3092 No. Lexington Ave., Roseville, Mn. 55113
LAND SURVEYING
483-4408


I Hereby Certify that this plat shows a survey made by me of the property described on this plat, and that the corners are correctly placed as shown, and that all locations have been correctly shown.

Job Number: 442
Surveyed For: Nika Pottenger
Date: 9/6/79
Scale: 1"=40'

By: Ronald W. Schmidt
REGISTERED LAND SURVEYOR

DESCRIPTION:
Lots 8, 9, 10, and the Westerly 51.30 Feet
of Lot 11, Block 1, Burlington Heights Division No. 1.

Ramsey County, Minnesota

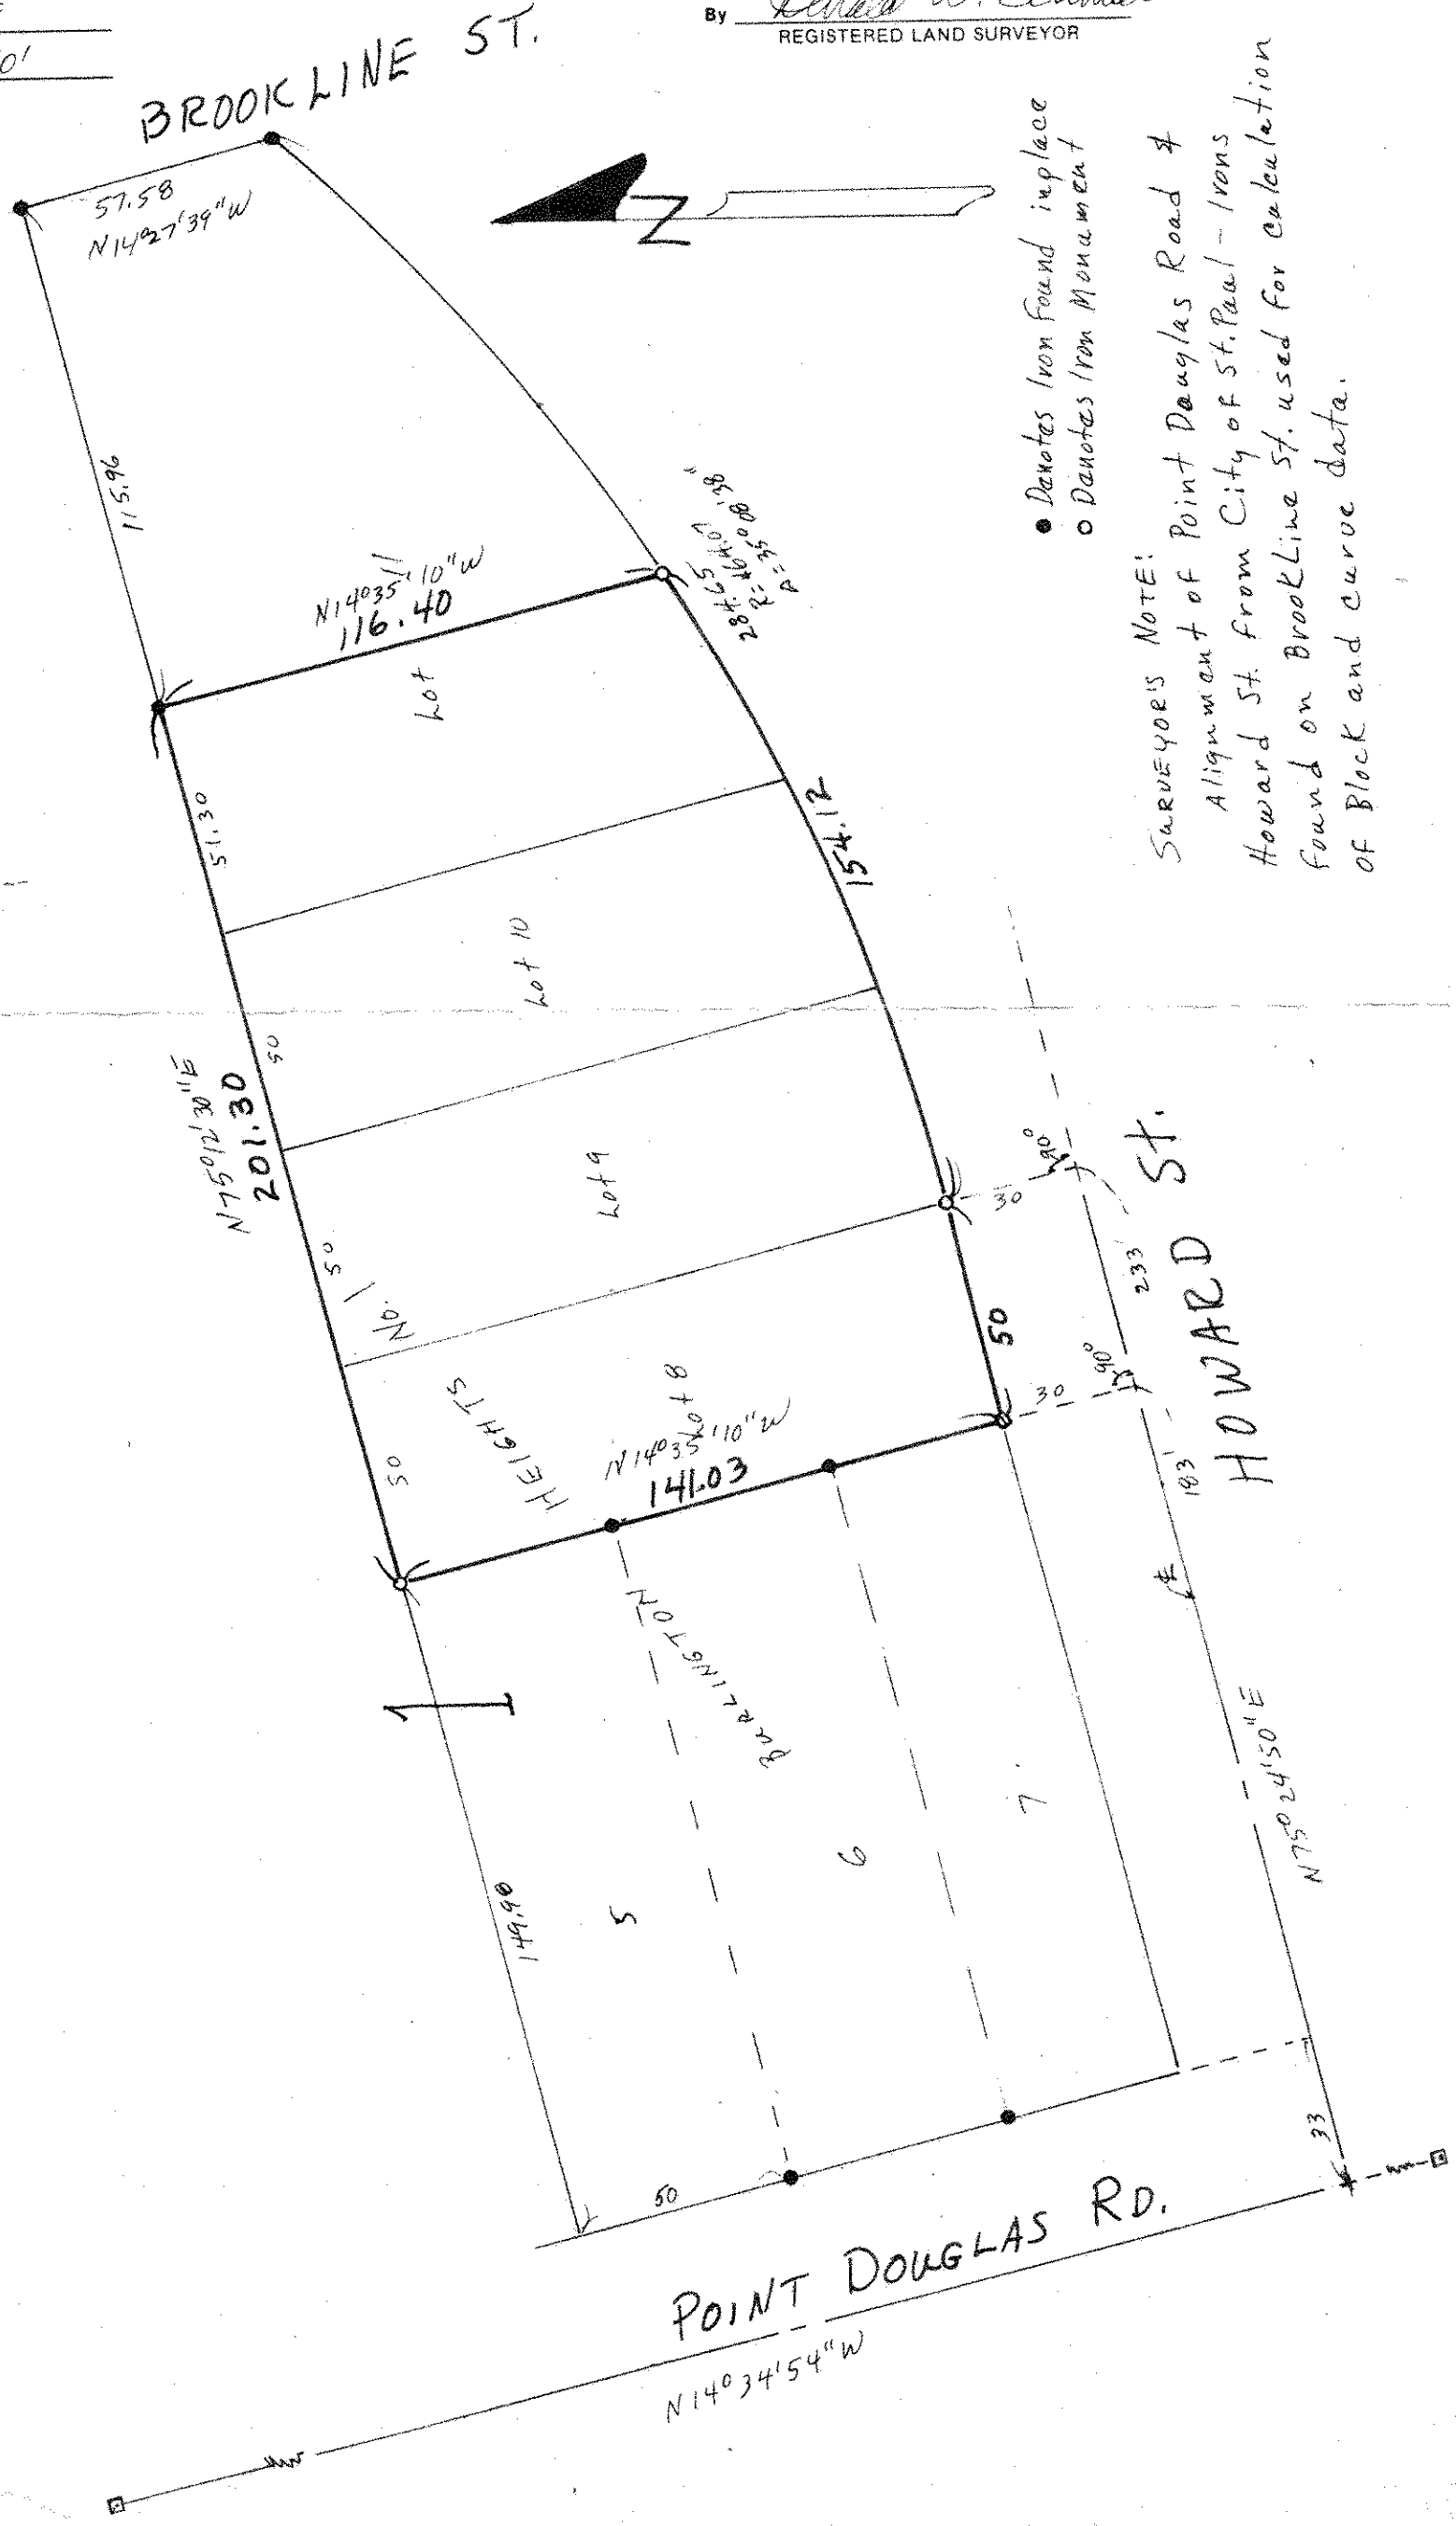

• Denotes Iron Found in place
○ Denotes Iron Monument

SURVEYOR'S NOTE:
Alignment of Point Douglas Road &
Howard St. from City of St. Paul - Irons
found on Brookline St. used for calculation
of Block and curve data.