


# PLAT OF SURVEY

OF PROPERTY OF John A. Hall

DESCRIBED AS FOLLOWS Commencing at the Southwest Corner of Lot 15, Block 5, of Burlington Heights, Division No. 1, Ramsey County, Minnesota, thence North along the West lines of Lots 12, 13, 14, and 15, in said Block, 200 ft. to the North-West Corner of Lot 12, in said Block; thence at right angles, East along the North lines of Lots 12. and 31, in said Block and the prolongation East of said line, 300ft. to a point, thence South at Right angles, 200ft. to a point, intersected by the prolongation East of the South line of Lots 15 and 28, in said Block, thence West along the last mentioned lines 300ft. to the point of beginning.

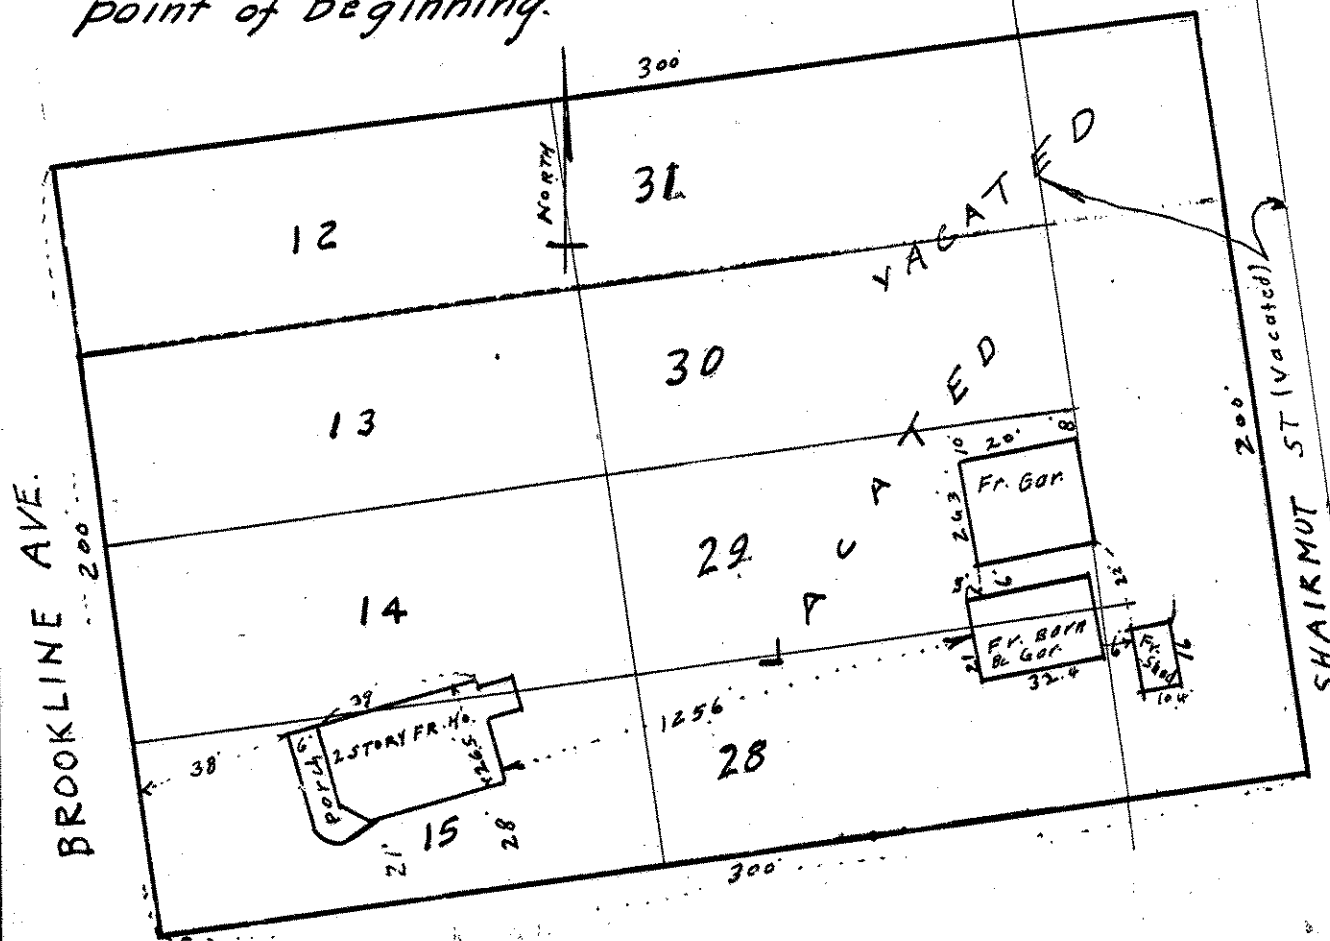

## CERTIFICATE OF LOCATION OF BUILDING

I hereby certify that on March 23, 1938

I made a survey of the location of the building on the above described property and that the location of said building is correctly shown on the above plat.

J. J. Welch

## CERTIFICATE OF SURVEY

I hereby certify that on March 23, 1938

I surveyed the property described above and that the above plat is a correct representation of said survey.

J. J. Welch