


PLAT OF SURVEY

OF PROPERTY OF Donald C. Erickson
DESCRIBED AS FOLLOWS Lots 14 and 15, Block 6, Burlington Heights
Division No 1
No 818 South Point Douglas Road, St. Paul, Minn.

SCALE: 1 INCH = 40 FEET

T. J. WELCH, REGISTERED SURVEYOR
701 EAST 3RD STREET, ST. PAUL, MINN. 55106

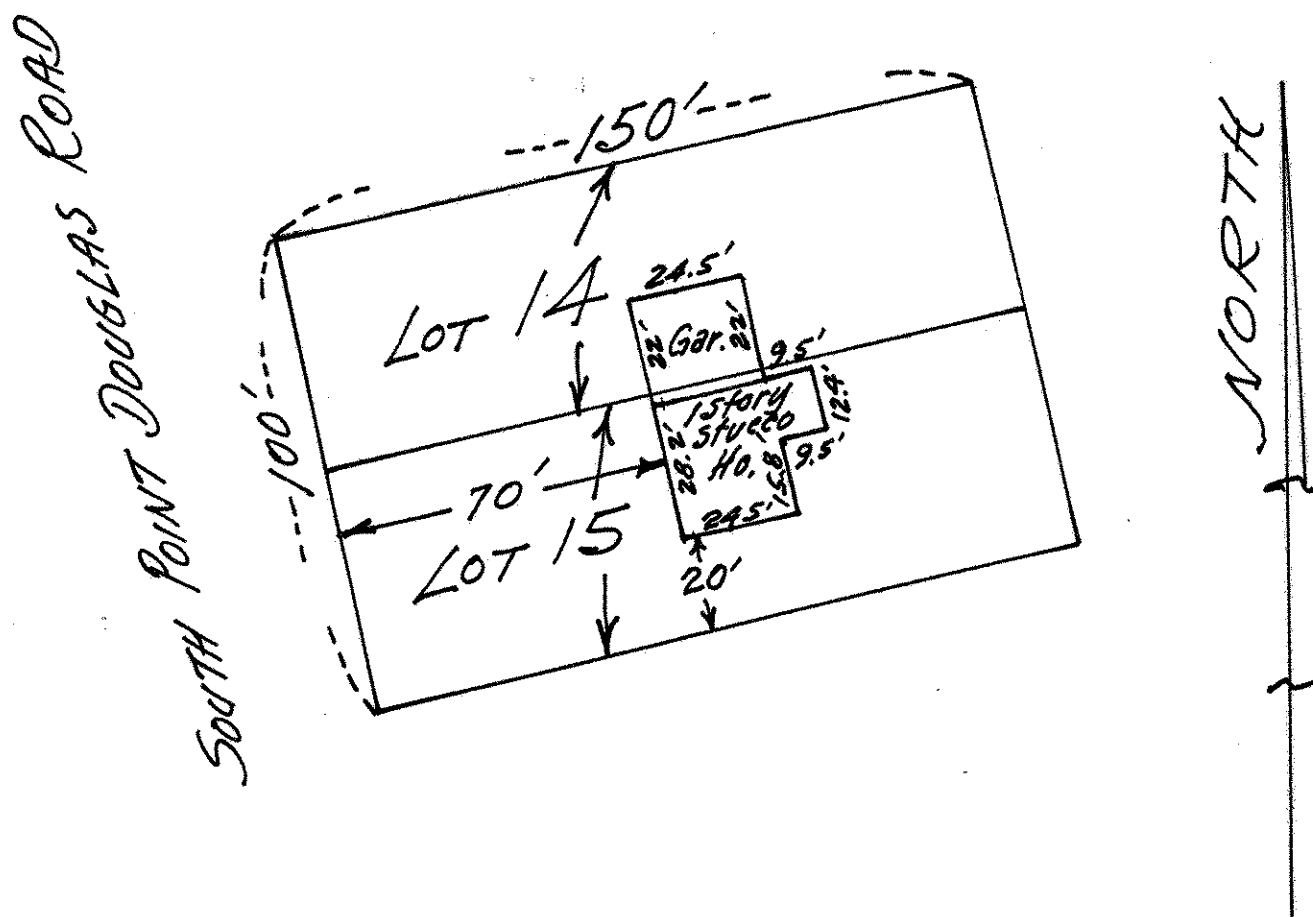

CERTIFICATE OF SURVEY

I hereby certify that on May 23, 1970

I surveyed the property described above and that the above plat is a correct representation of said survey.

J. J. Welch

This survey is made exclusively for First Federal Savings & Loan Assn. of St. Paul. Lot lines are not guaranteed as this is survey for mortgage purposes only.

342/15