

3
TELEPHONE 776-0640

PLAT OF SURVEY


OF PROPERTY OF ARNOLD STROM

DESCRIBED AS FOLLOWS LOT 3, BLOCK 1, BURLINGTON HEIGHTS

DIVISION No 1

SCALE: 1 INCH = 40 FEET
● DENOTES IRON

T. J. WELCH, REGISTERED SURVEYOR
701 EAST 3RD STREET, ST. PAUL, MINN. 55106

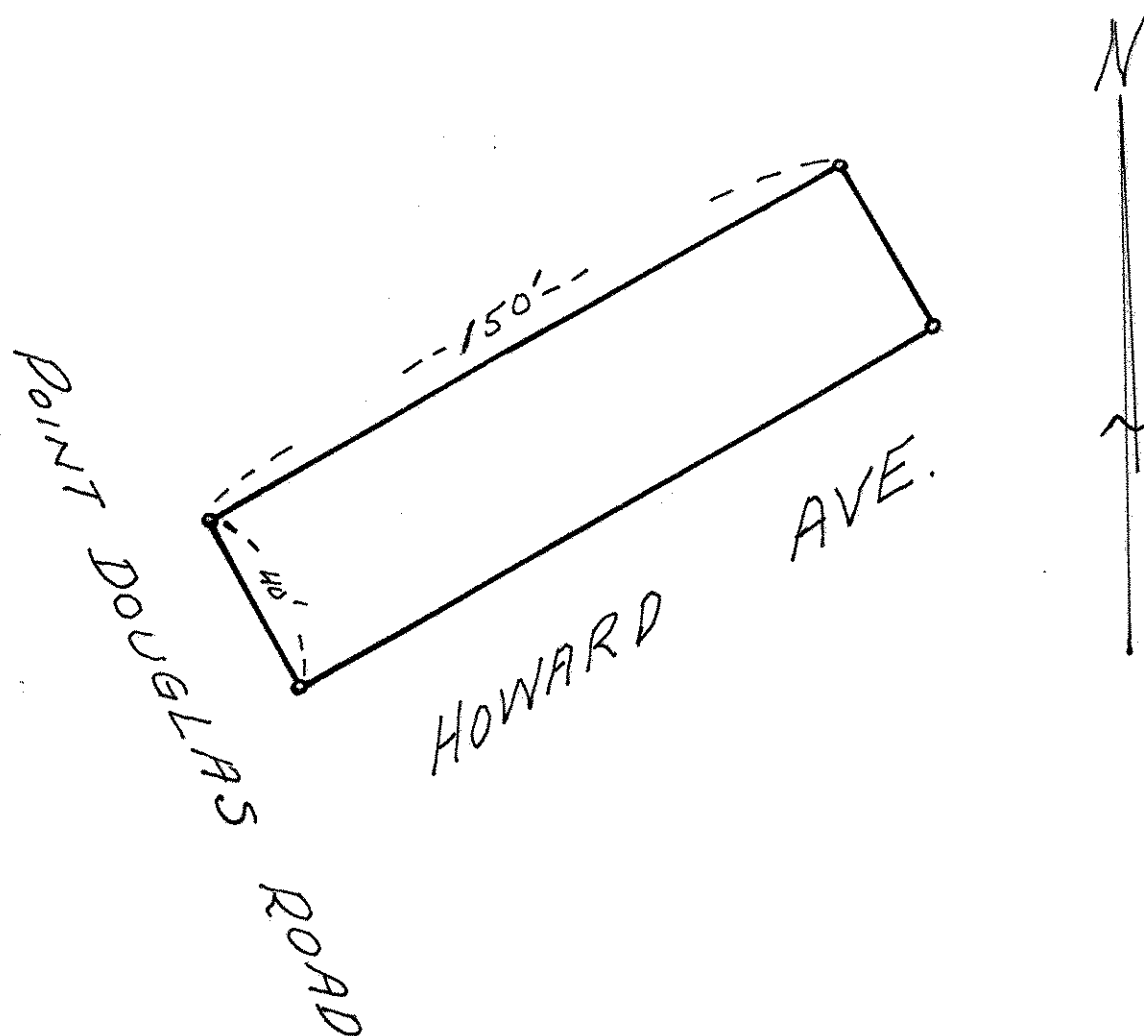

CERTIFICATE OF SURVEY

I hereby certify that on May 25, 1912
I surveyed the property described above and that the above
plat is a correct representation of said survey.

T. J. Welch