


REGISTERED CIVIL ENGINEER AND LAND SURVEYOR

Scale $1" = 50'$

REGISTERED LAND SURVEYOR

* Walkway easement not of record, but in use. Attached is a copy of pending easement.

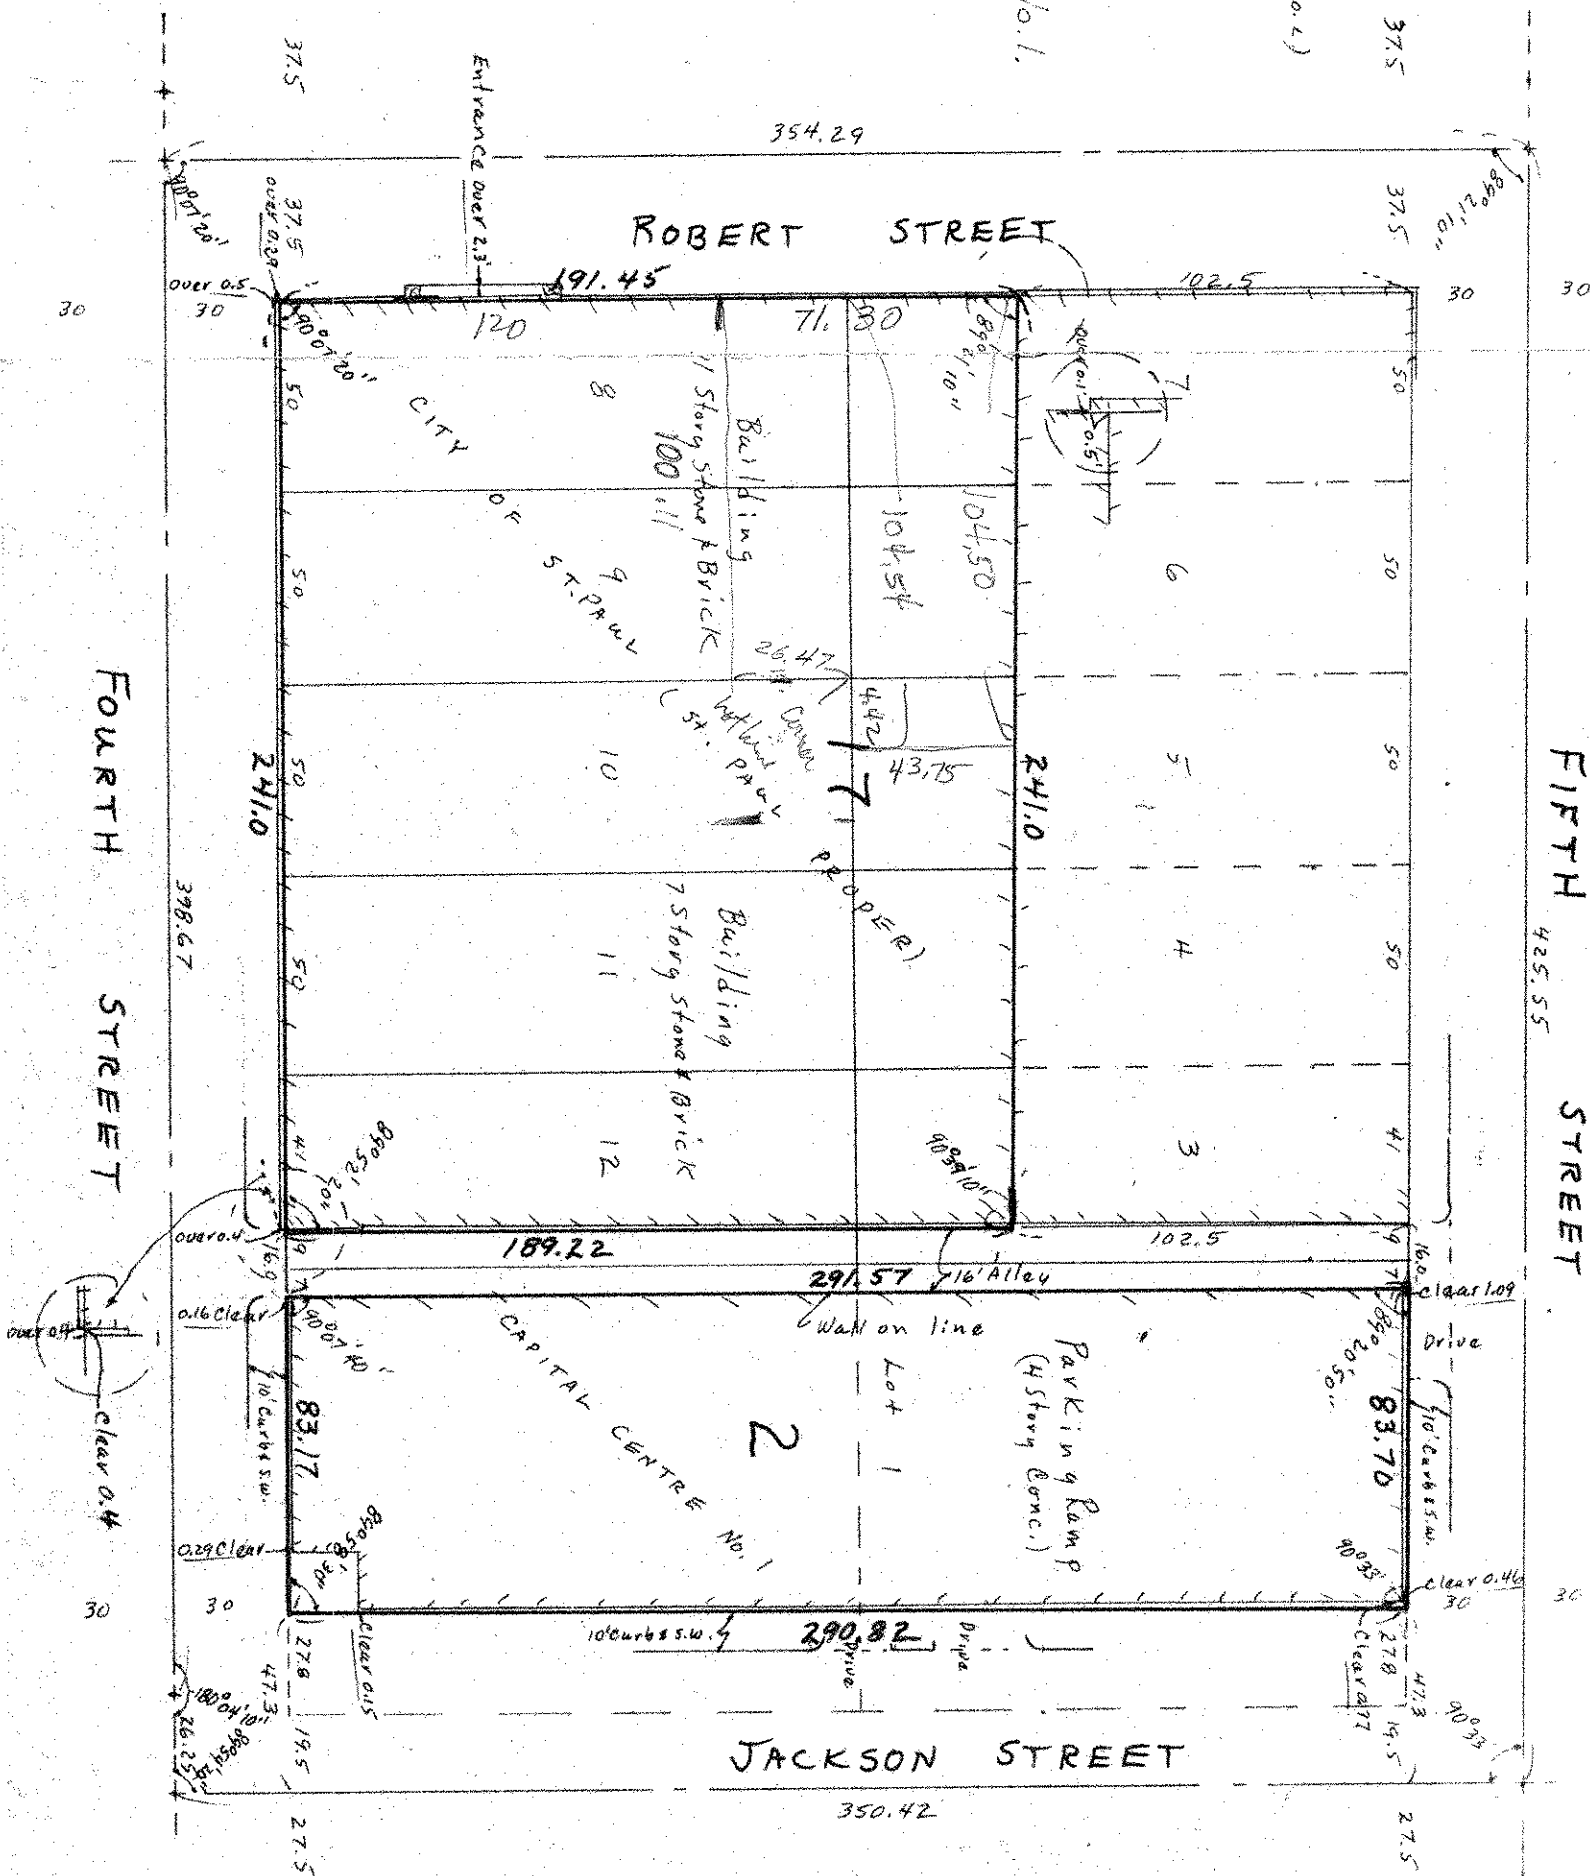

322

157-158

551-559

557-560

W
1
6