


Raasch
Bisanz Swiss Meadows

North line of SE of NE of NE 14-28-22

657.36
588 51 45 E

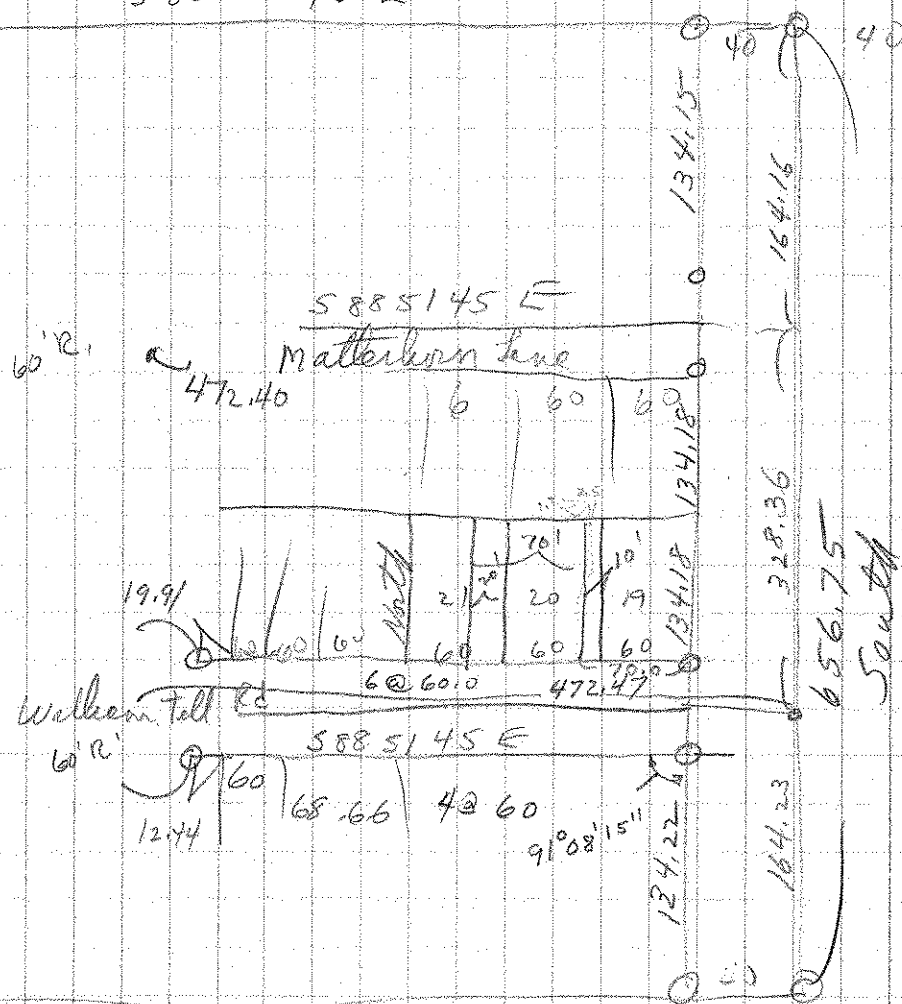

S 88 51 30 E

657.51

South line of SE $\frac{1}{4}$ of NE $\frac{1}{4}$ of NE $\frac{1}{4}$

14-28-22