


RANGE 22

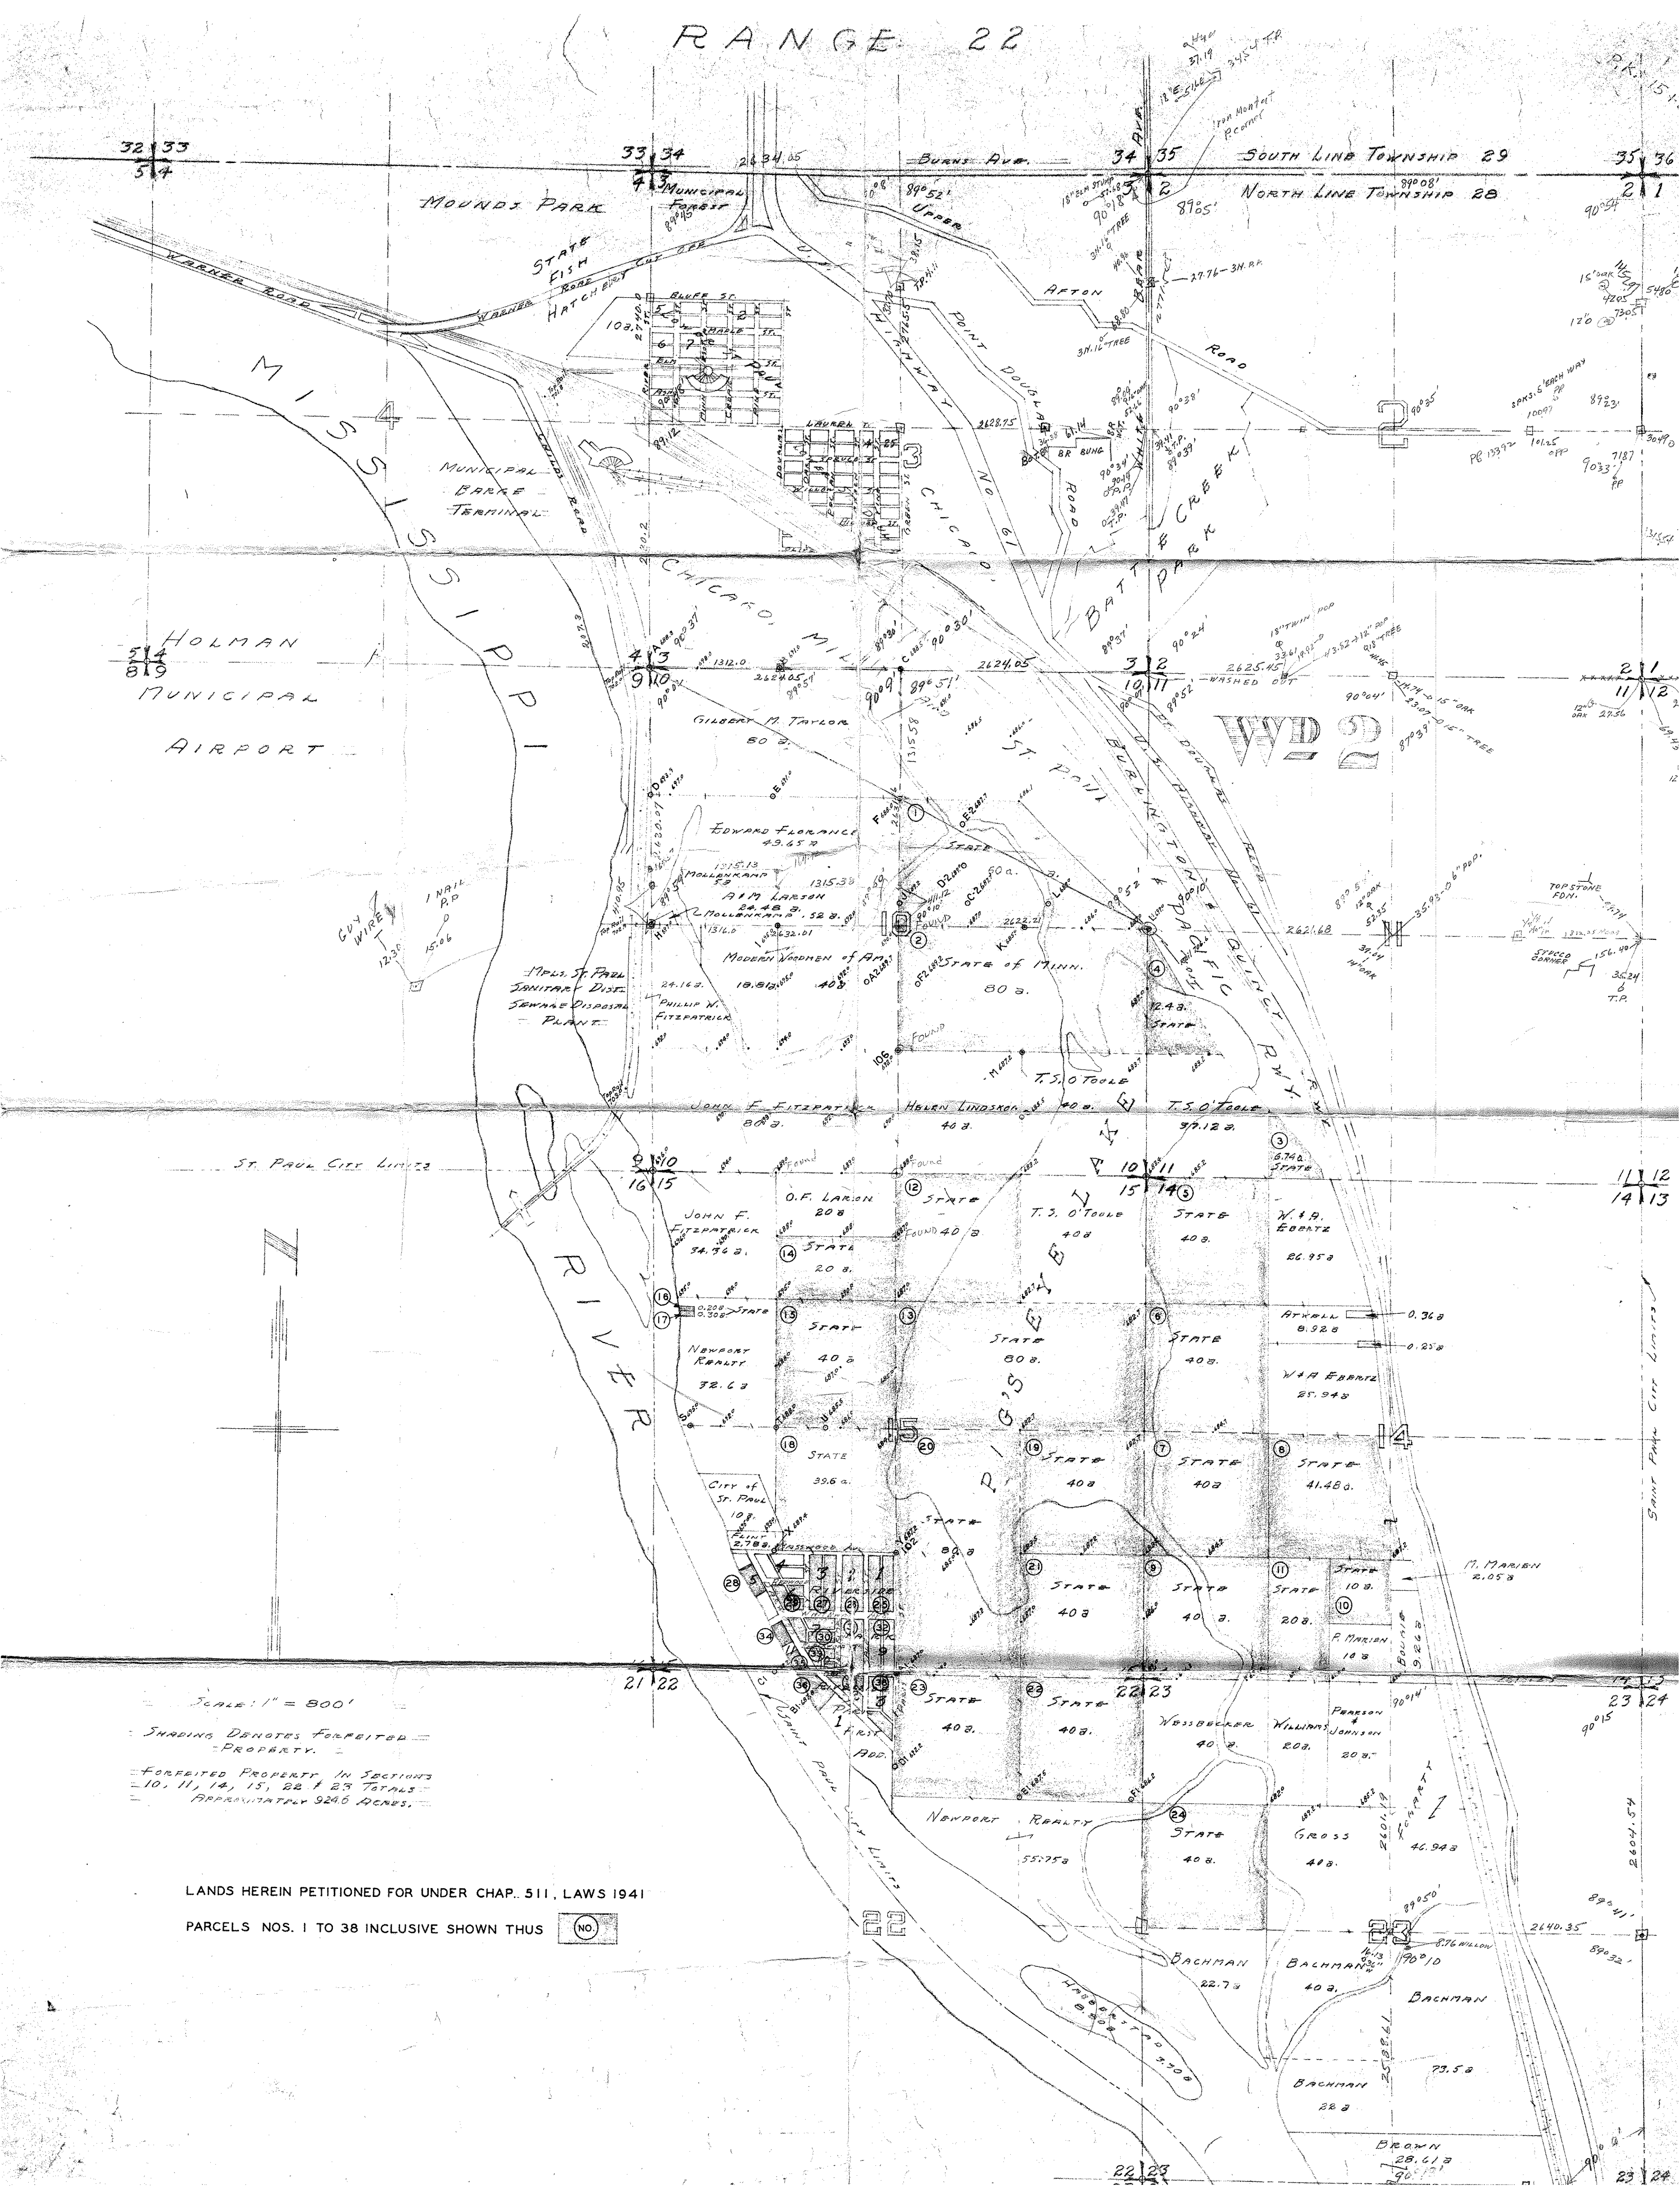

Scale: 1" = 800'

Shading Denotes Forfeited Property.

Forfeited Property in Sections 10, 11, 14, 15, 22 & 23 Totals Approximately 9246 Acres.

LANDS HEREIN PETITIONED FOR UNDER CHAP. 511, LAWS 1941

PARCELS NOS. 1 TO 38 INCLUSIVE SHOWN THUS

