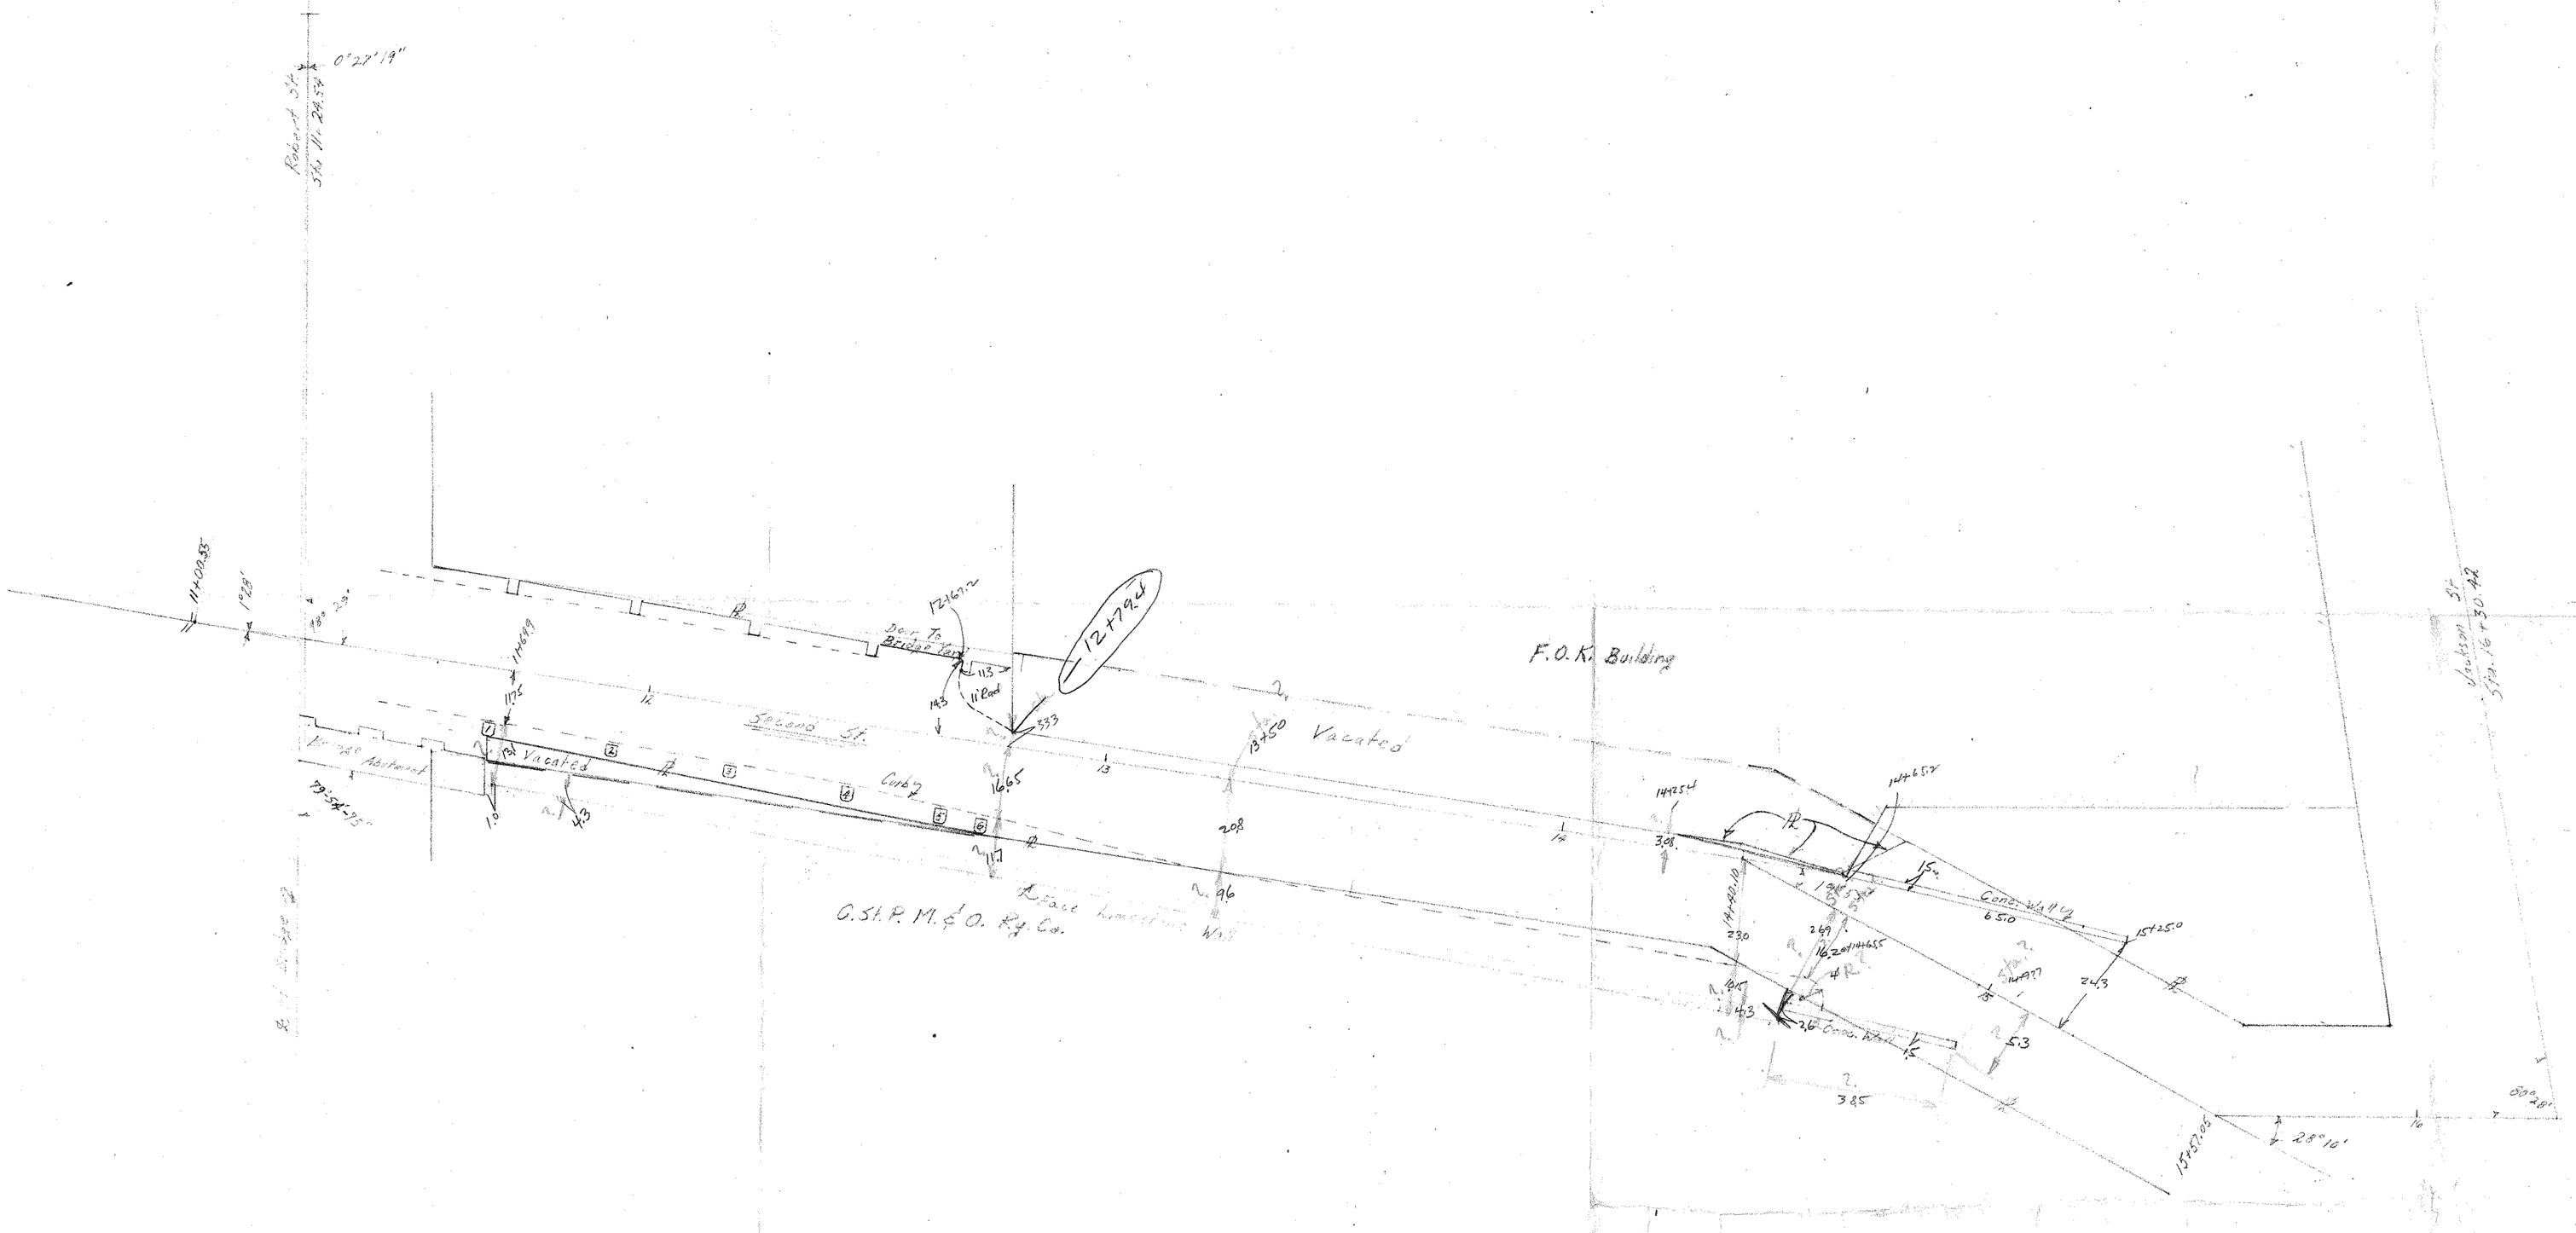

Return to Irv Forsberg so that data can be placed in F.B. 1204C

SECOND ST.
From Robert St. To Jackson St.

28 22

F.B. 1204C
DRWG. P.H. 73