


144.22
 2 Alley
 To 4th
 Pl Cedar
 to a.B. as staked
 145.6

CEDAR

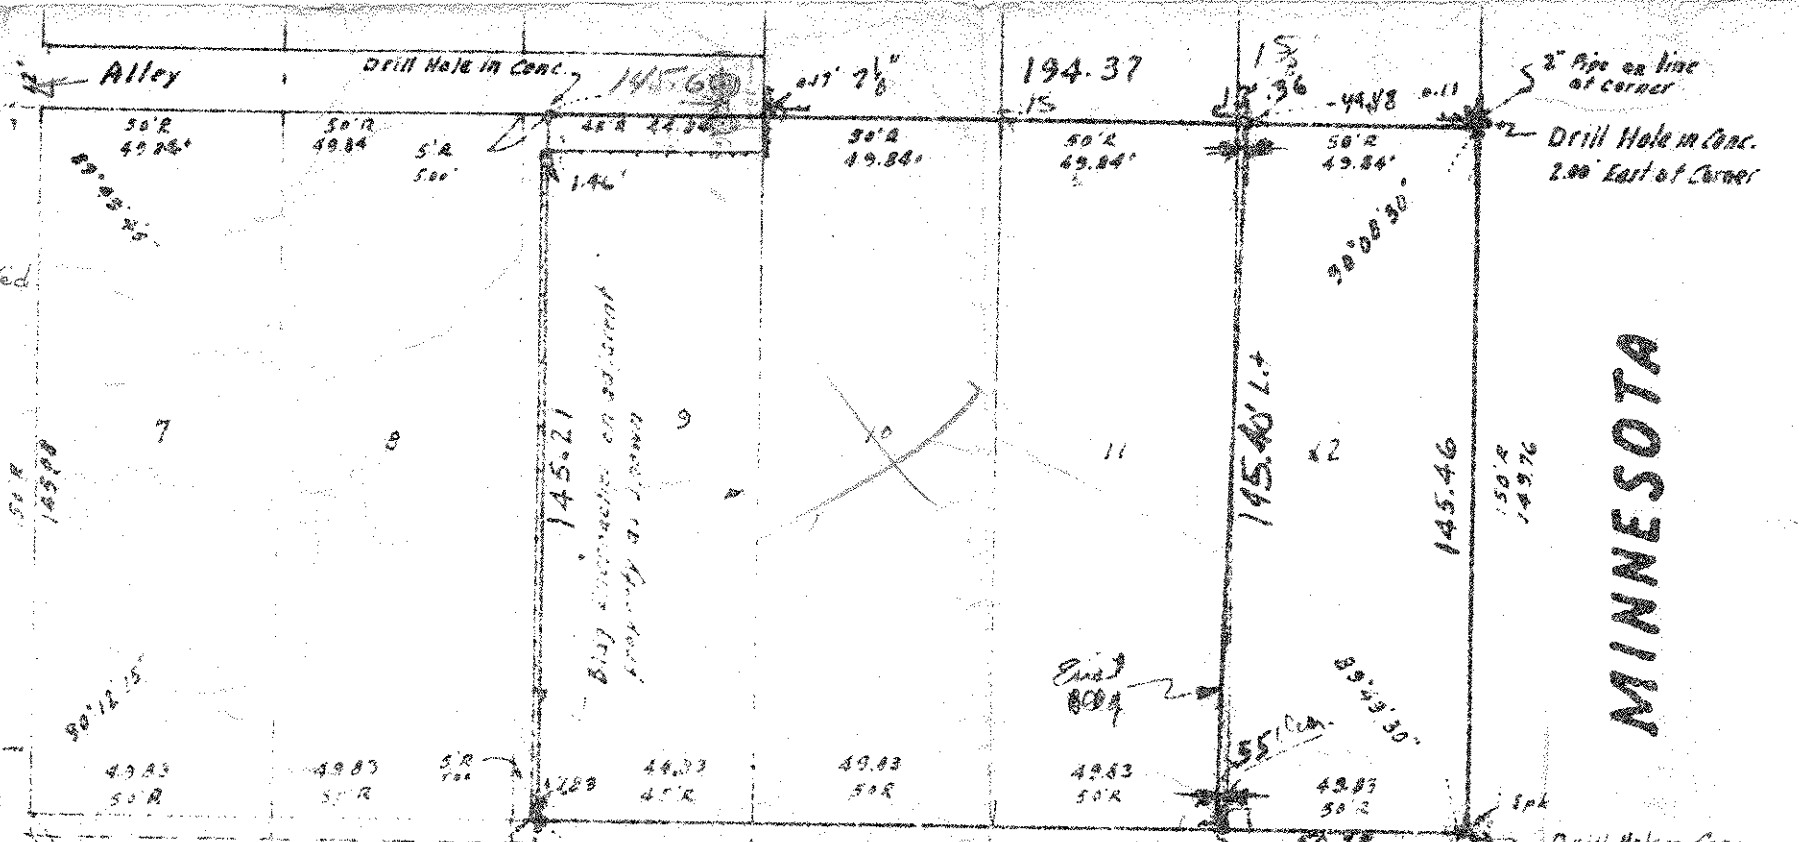

E. KELLOGG

BLVD.

MINNESOTA

Note

146.8
 146.3
