


~ PLAT OF SURVEY ~

Lots 1 thru 16 inclusive, Block 9 and Lots 44 thru 48 inclusive, Block 10, Burlington Heights Division No 1, Ramsey County, Minnesota.

SCALE: 1" = 50'

• DENOTES IRON

T. J. Welch
Registered Surveyor
701 East 3rd St
ST. PAUL, MINN. 55106
Tel. 776-0640
December 19, 1970

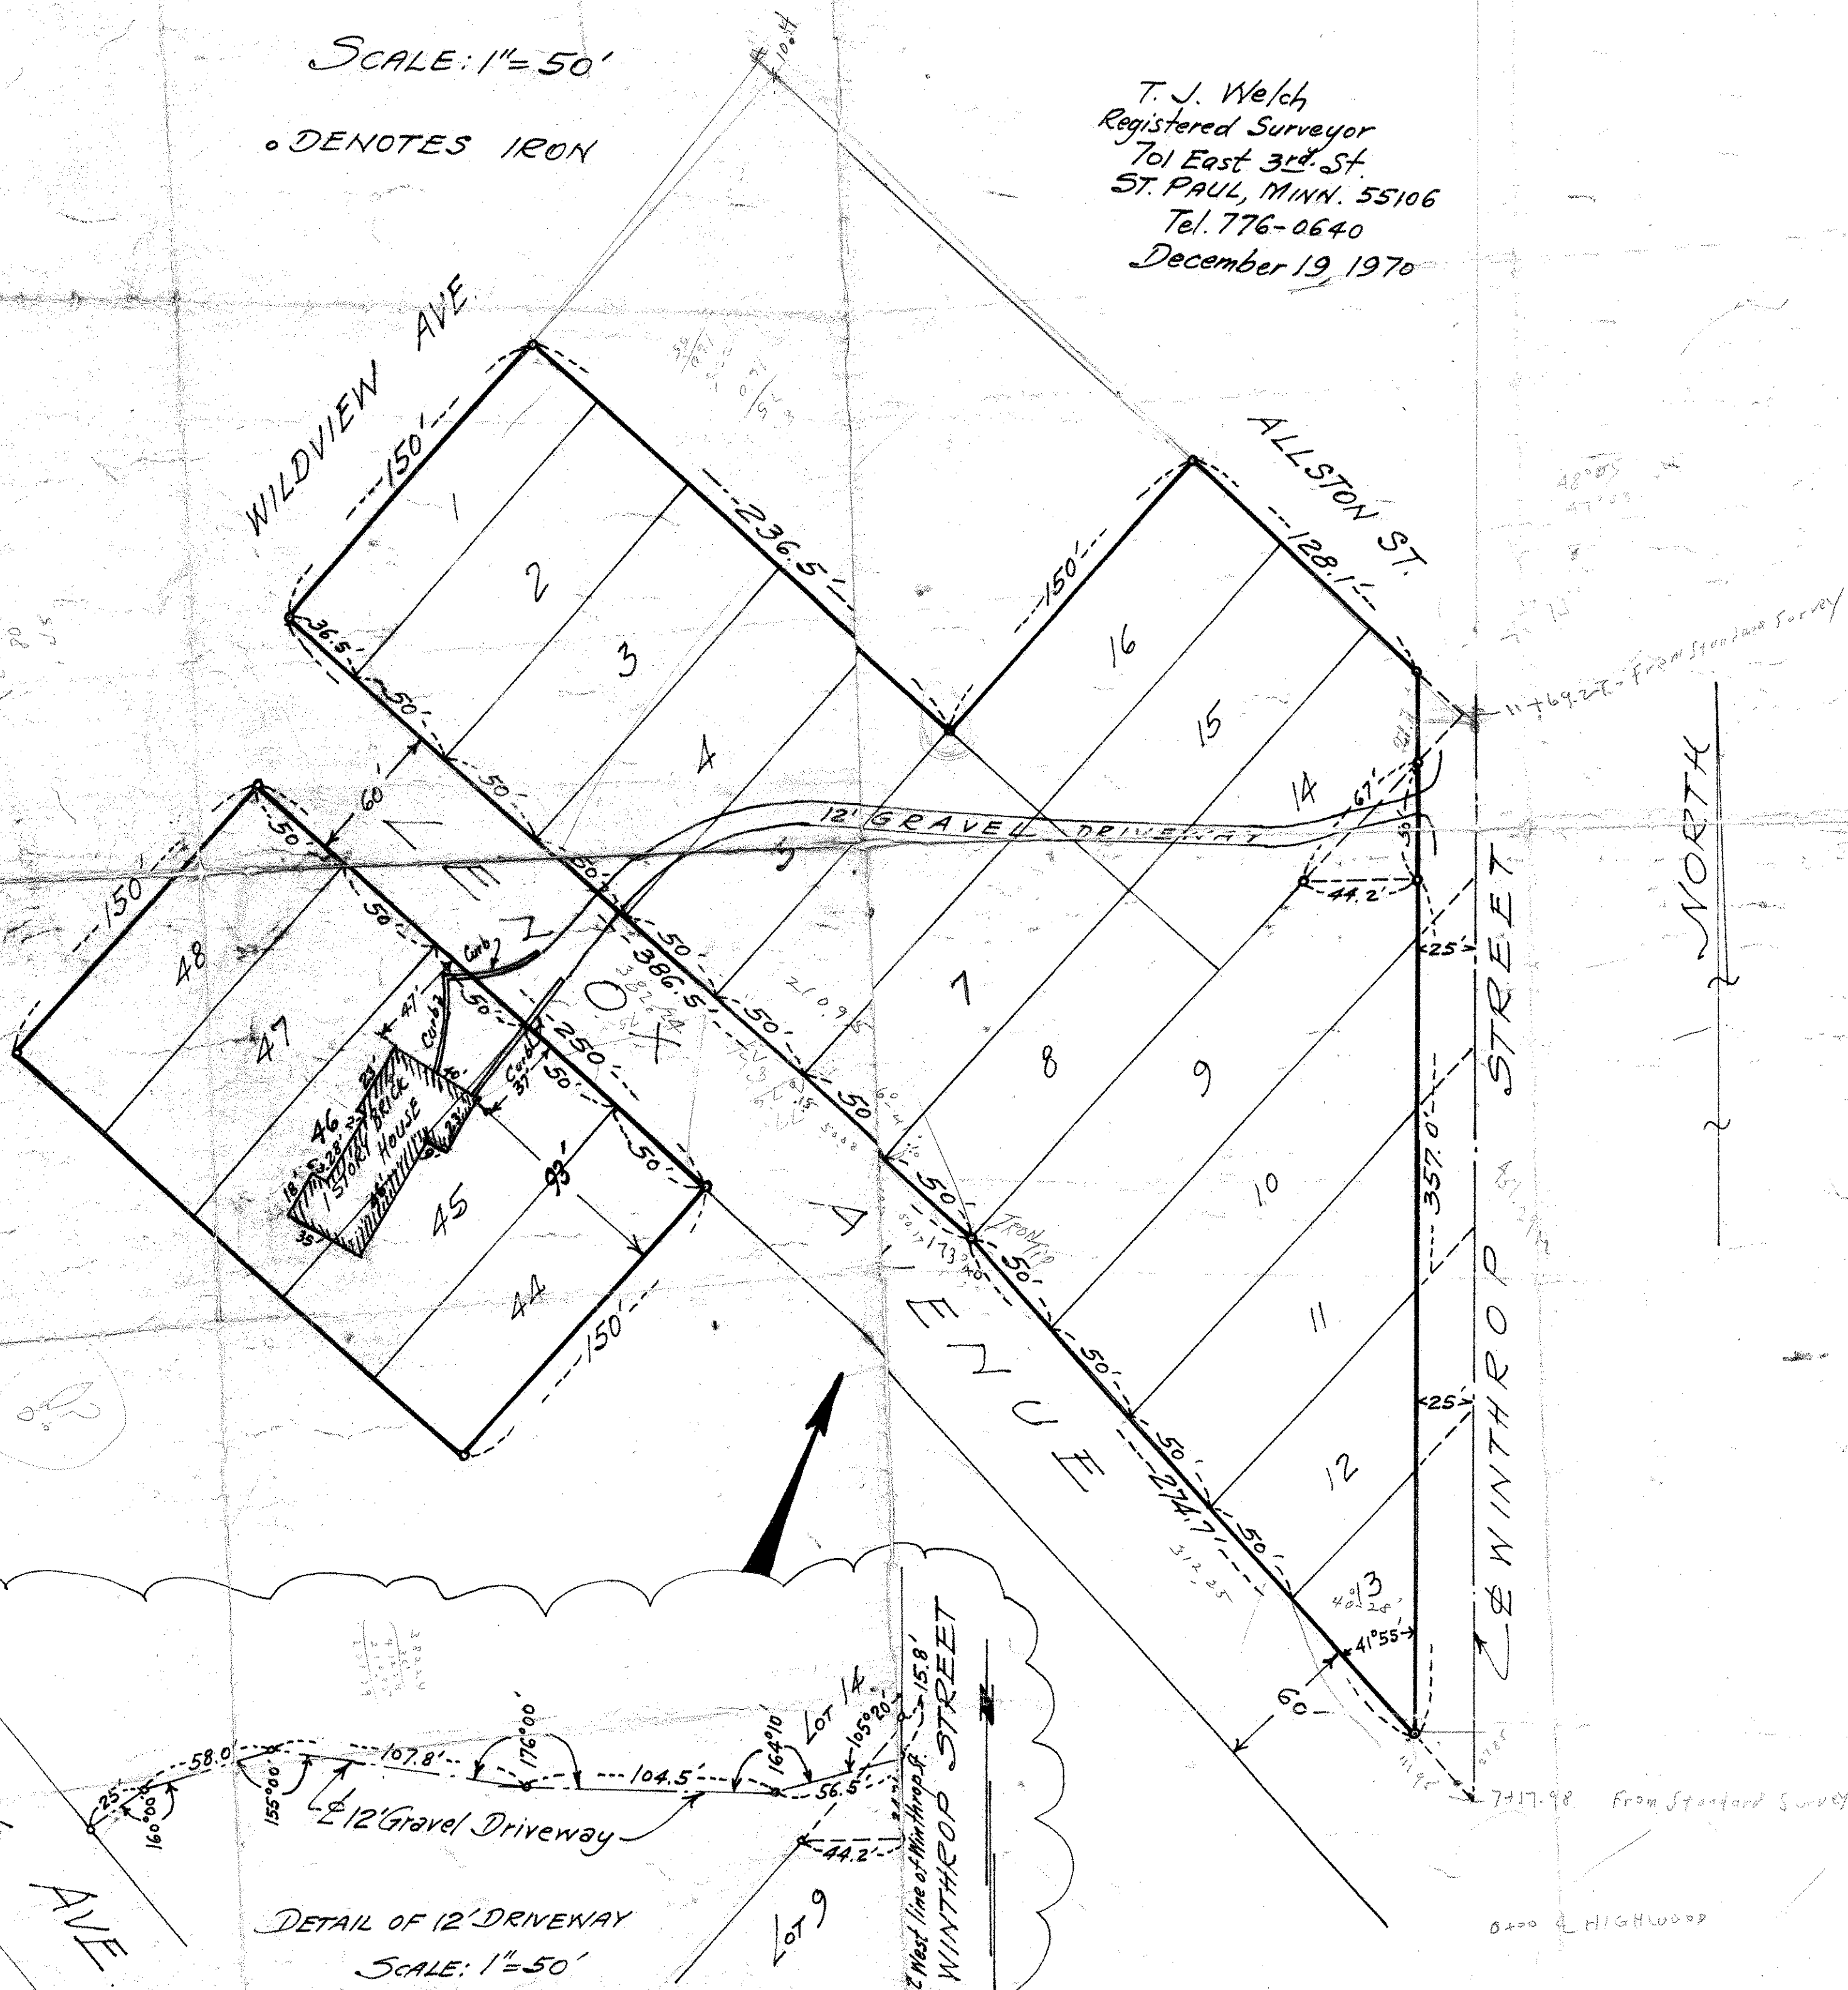

DETAIL OF 12' DRIVEWAY
SCALE: 1" = 50'