


PLAT OF SURVEY
Lots 9-10-11-12 and 13, Block 9 Burlington Heights Division No. 1.

T. J. WELCH
Registered Surveyor
701 E. 3rd. Street
ST. PAUL, MINN. 55106
TEL. 776-0640
July 17, 1967

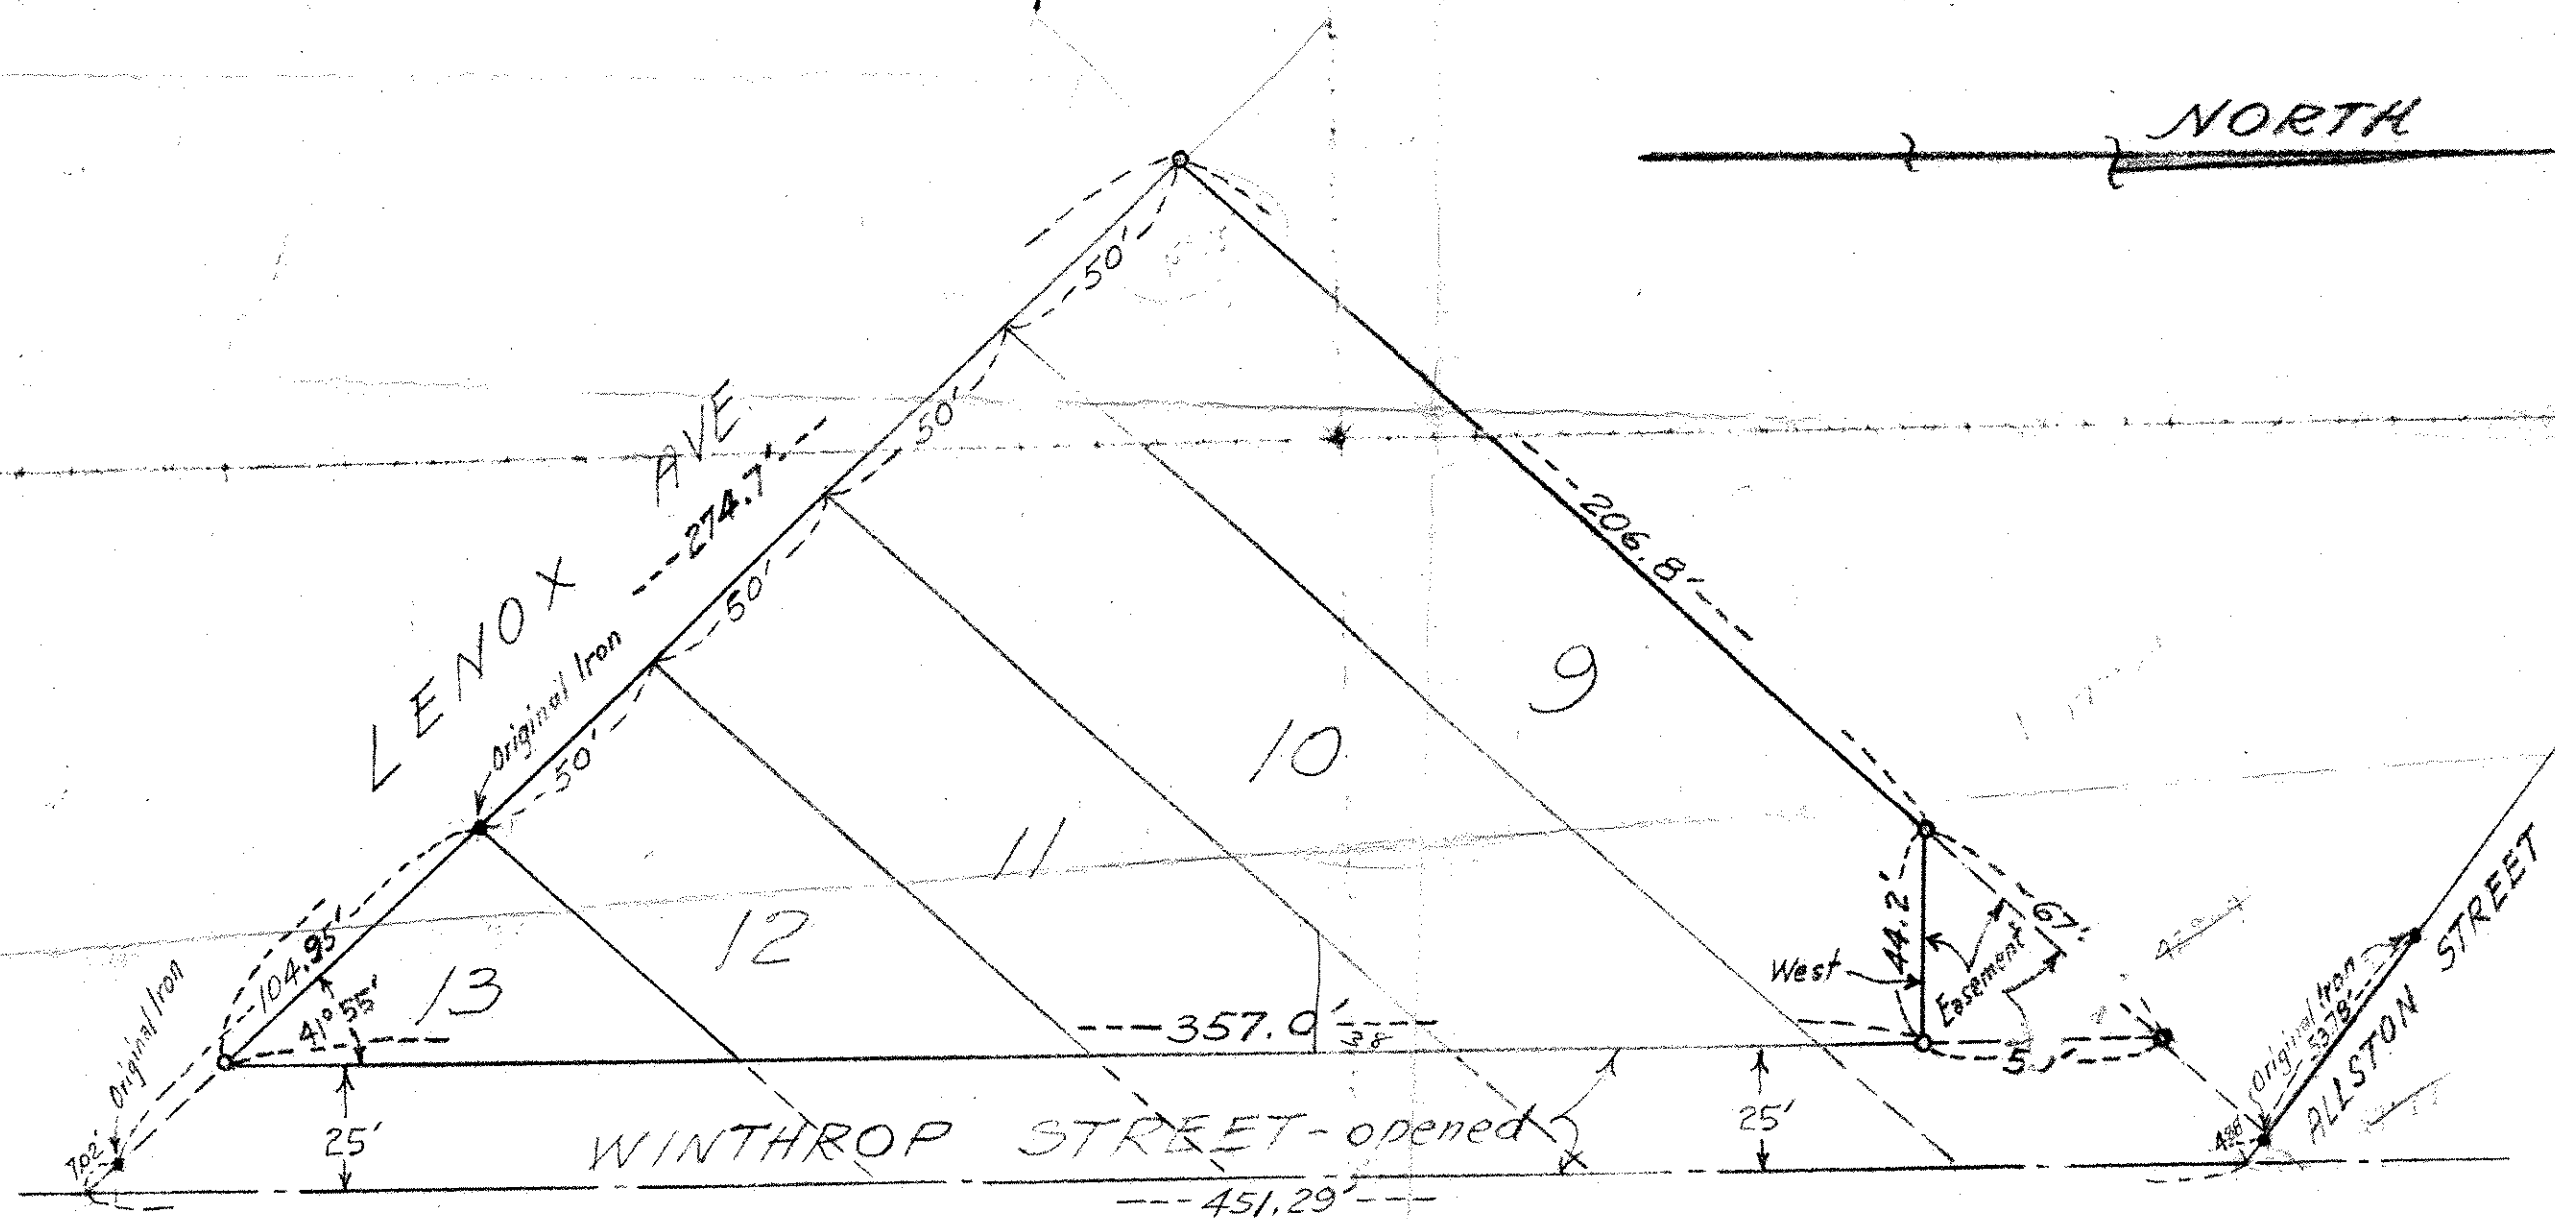

$\begin{array}{r} 91 \text{ } 1 \text{ } 3 \\ 95 \text{ } 1 \text{ } 3 \\ \hline 136 \text{ } 11 \text{ } 0 \\ 125 \text{ } 16 \text{ } 10 \\ \hline 137 \text{ } 15 \text{ } 0 \end{array}$
 $72 \text{ } 1 \text{ } 10$