


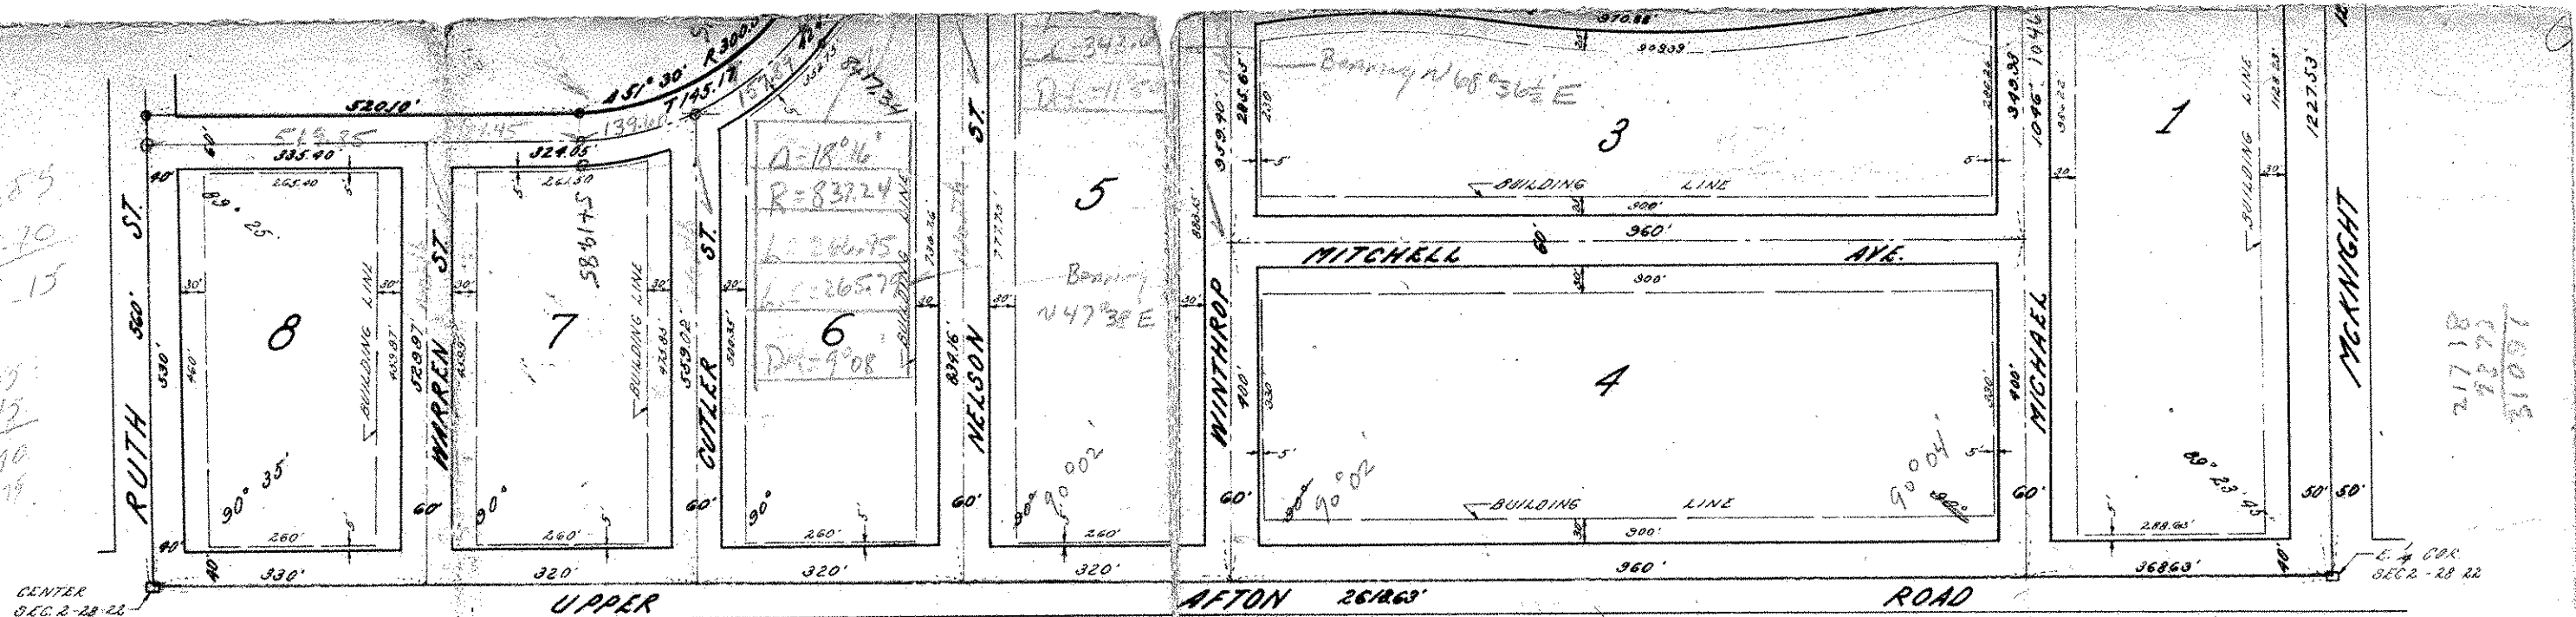

I HEREBY CERTIFY TO HAVING SURVEYED THE PROPERTY DESCRIBED ON THIS PLAT AS "BATTLE CREEK HEIGHTS PLAT 1" AND HAVE PLACED IRON MONUMENTS AT THE CORNERS AS SHOWN AND THE SAME IS CORRECT. THERE IS NO LOW WET GROUND NOR ANY TRAVELED ROAD OR EASEMENT ON OR ACROSS SAME EXCEPT AS SHOWN.

Ernest J. Forsberg
REGISTERED SURVEYOR MINN. CERT. NO. 1734

STATE OF MINNESOTA)
COUNTY OF RAMSEY) SS.

ON THIS 8th DAY OF Sept A.D. 1959
BEFORE ME THE UNDERSIGNED PERSONALLY APPEARED IRVING S. FORSBERG TO ME KNOWN TO BE THE PERSON DESCRIBED IN AND WHO EXECUTED THE FOREGOING INSTRUMENT AND ACKNOWLEDGED THAT HE EXECUTED THE SAME AS HIS FREE ACT AND DEED.

J. A. Wolcott
NOTARY PUBLIC, RAMSEY CO. MINN.
MY COMMISSION EXPIRES May 26 - 1965