28 22

27 MIN. BLOCK COR.?

56.35

MON. AT STARKEY & WATER

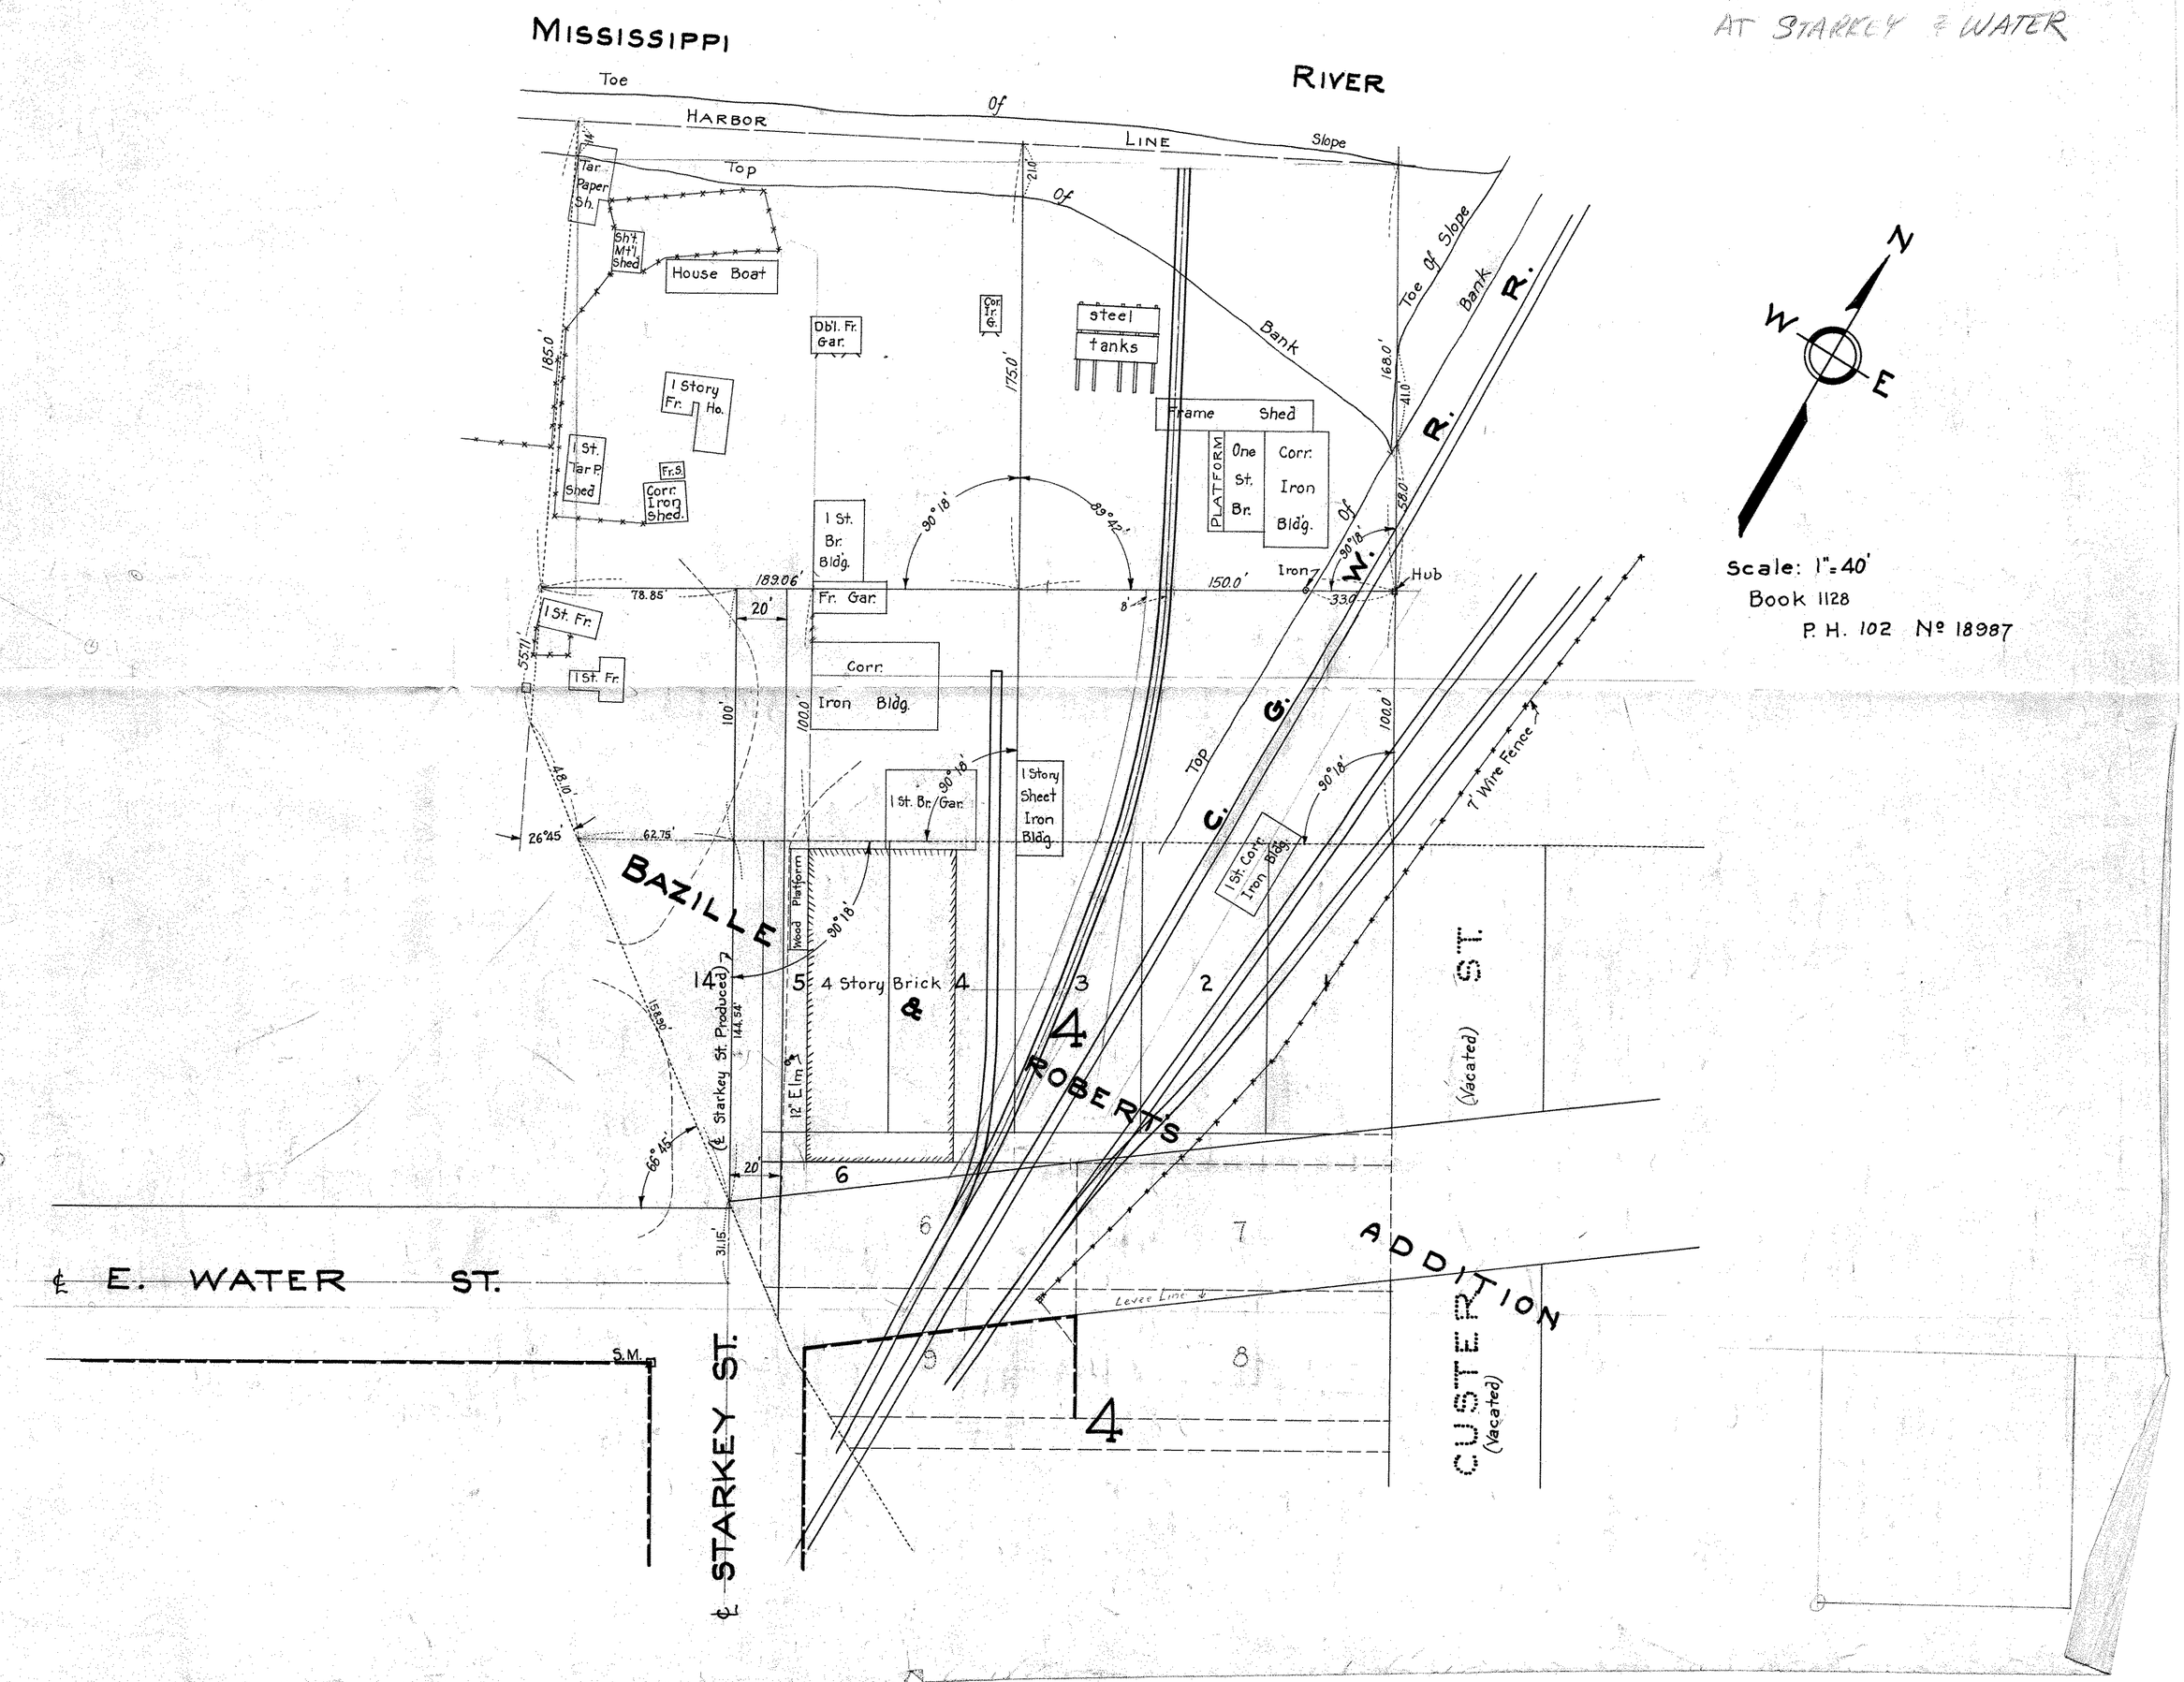

Scale: 1"=40'
Book 1128
P. H. 102 № 18987

25150